


T. 14 S. R. 8. W. W. M.

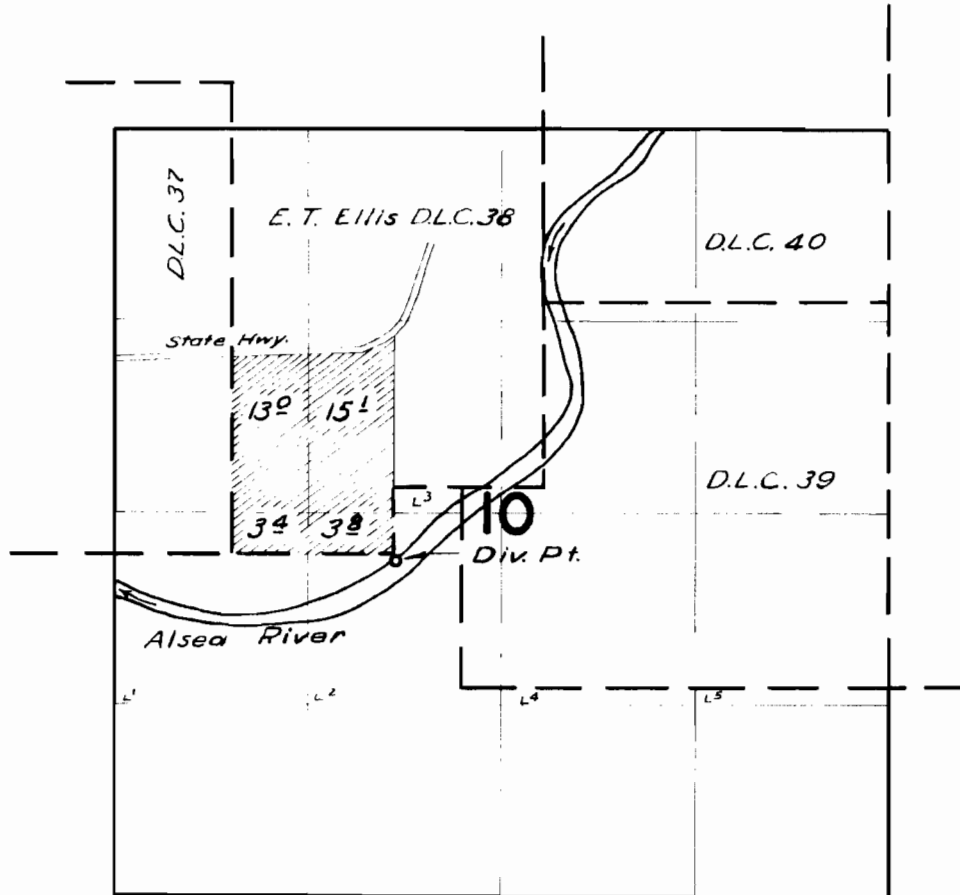

FINAL PROOF SURVEY UNDER

Application No. 28050 . Permit No. 22065
IN NAME OF

LIAL & BRICE WINNEY

Surveyed 17 Mar. 1959, by *M. Bush*