


T. I. S. R. 2 E. W. M.

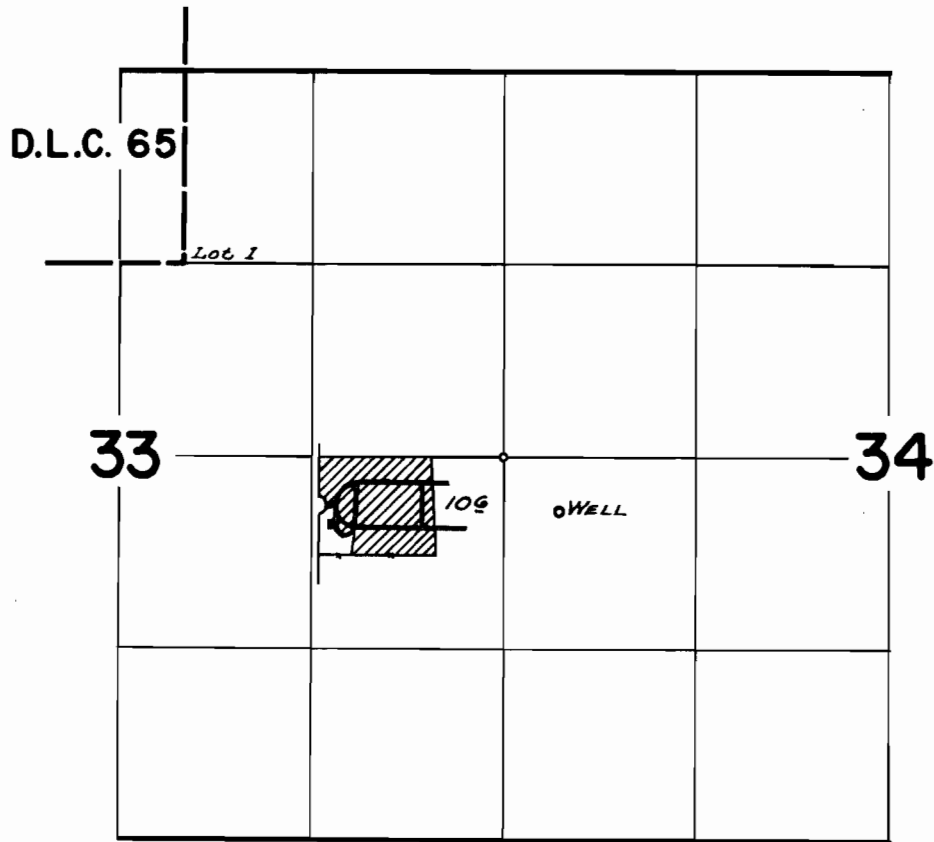

FINAL PROOF SURVEY UNDER

Application No. 6-604 Permit No. 6-505
IN NAME OF

ARCHDIOCESE OF PORTLAND IN OREGON,

Surveyed April 4, 1961, by

[Handwritten Signature]