


T.2S.R.2E.W.M.

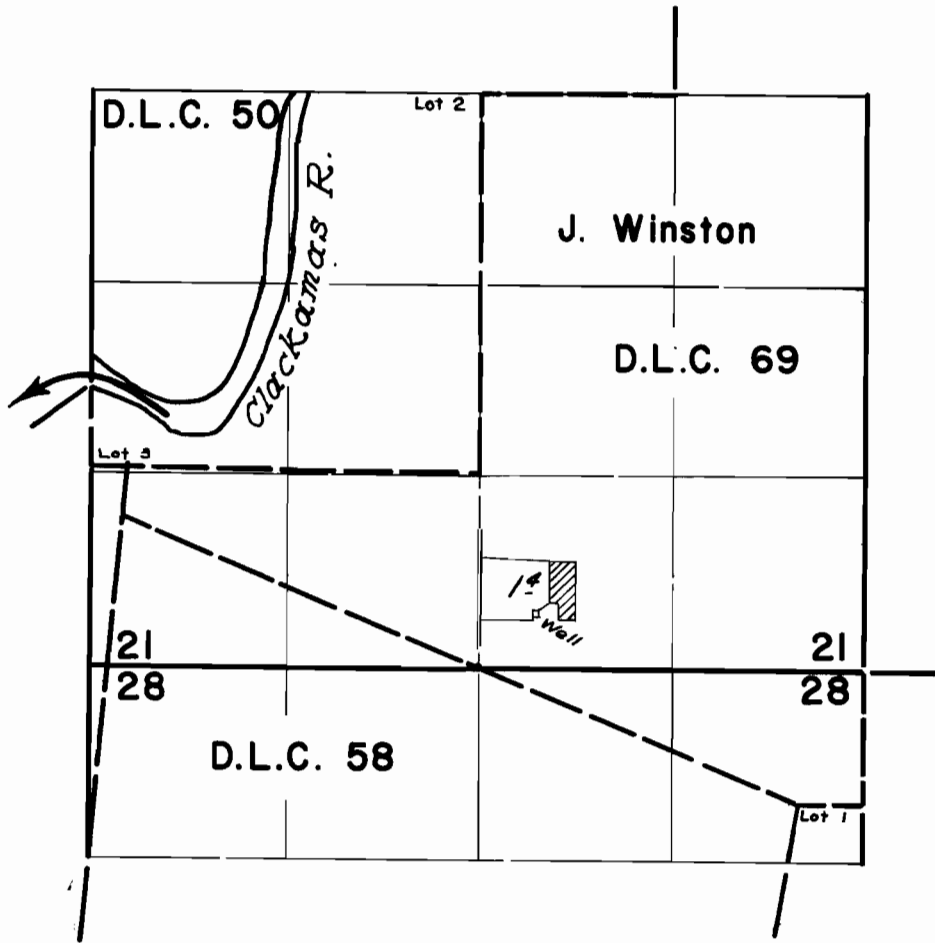

FINAL PROOF SURVEY
UNDER

Application No. G-598 Permit No. G-529
IN NAME OF

IRVIN WESTENSKOW

Surveyed June 2, 1961, by R. Jackson