


T.2S. R.3E.W.M.

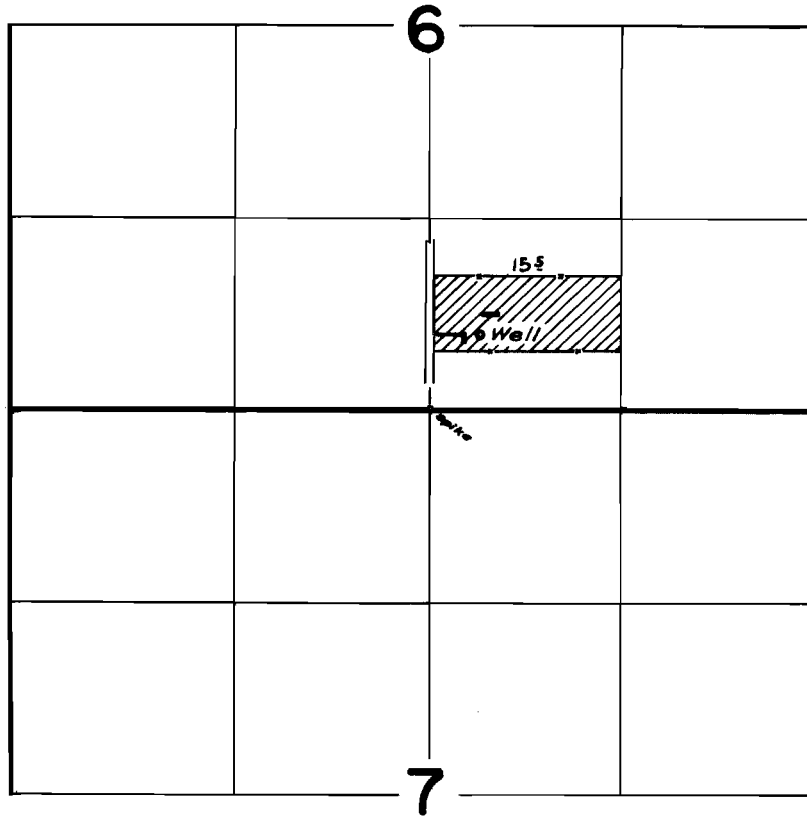

FINAL PROOF SURVEY
UNDER

Application No. 9-763... Permit No. 9-671....
IN NAME OF

JEDEDIAH WILLIAM AYLETT

Surveyed April 5... 1961., by *A. Peterson*