


T.3S.R.1E.W.M.

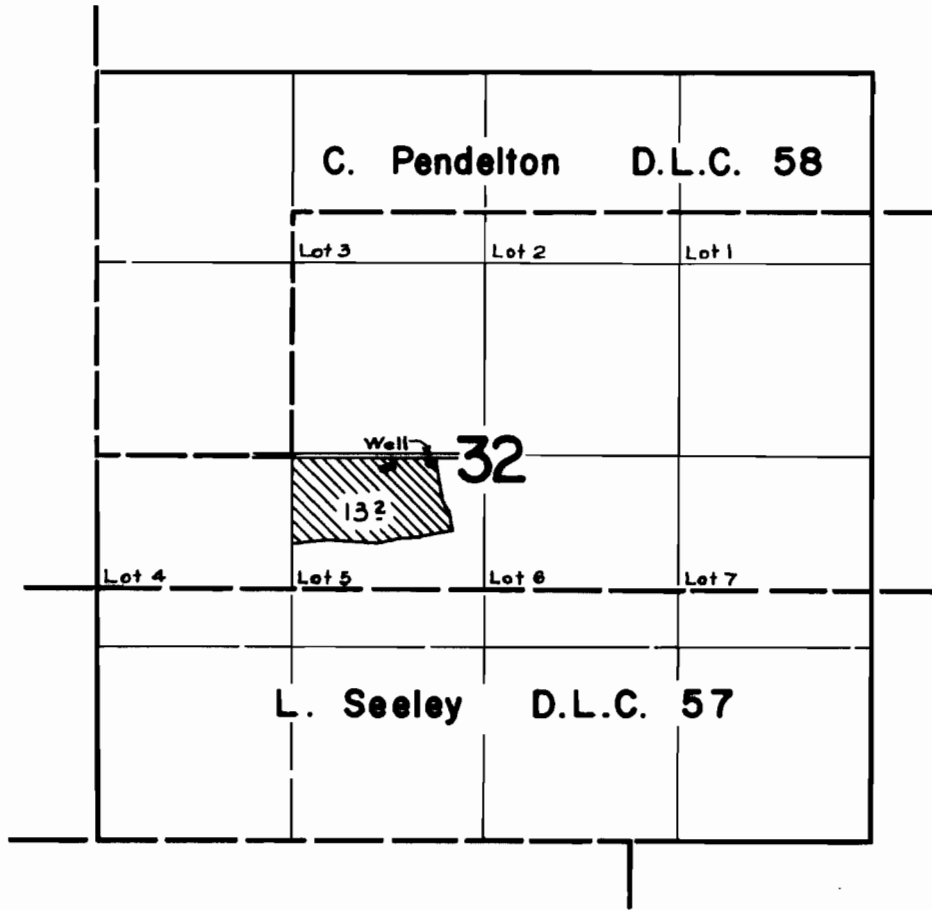

FINAL PROOF SURVEY UNDER

Application No. G-939..... Permit No. G-835...
IN NAME OF

ELTON I. HIGBEE

Surveyed May 19 1961., by

[Signature]