


T. 2 S. R. 1 E. W. M.

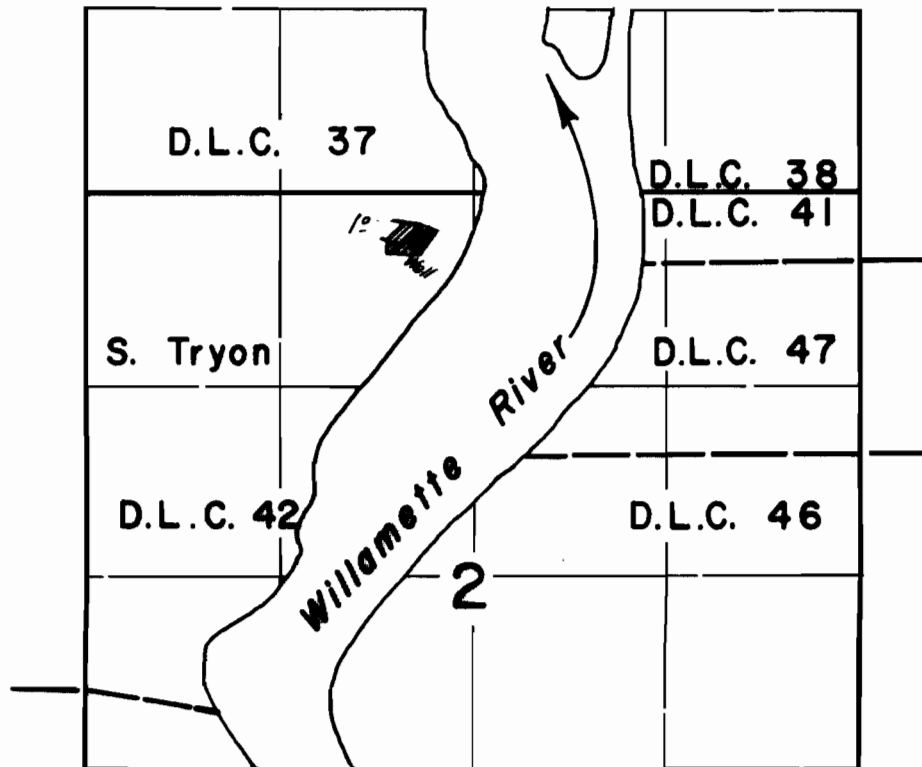

FINAL PROOF SURVEY UNDER

Application No. G-977. Permit No. G-866.
IN NAME OF

E. W. & FRANCIS P. HAGGERTY

Surveyed April 3 1961, by