


T.3S. R.1 E.W.M.

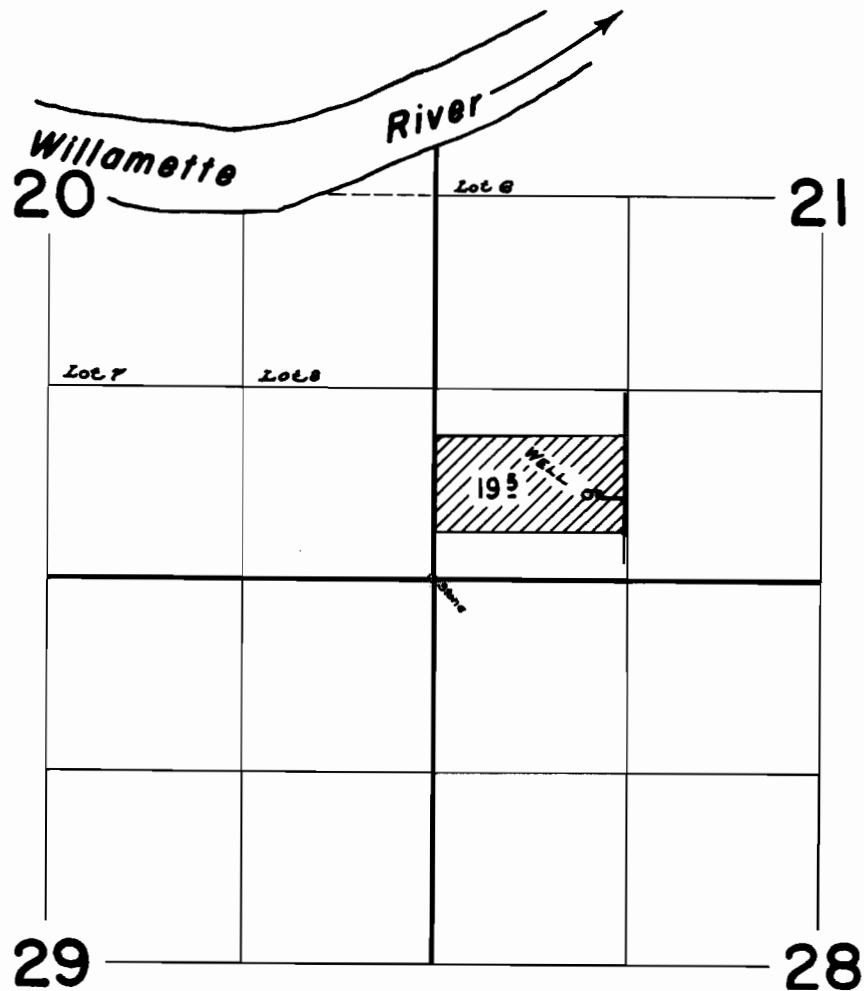

FINAL PROOF SURVEY
UNDER

Application No. G-997 Permit No. G-895
IN NAME OF

VICTOR HODEL

Surveyed March 20 1961, by

[Signature]