


T. 3 S. R. 1 W. W. M.

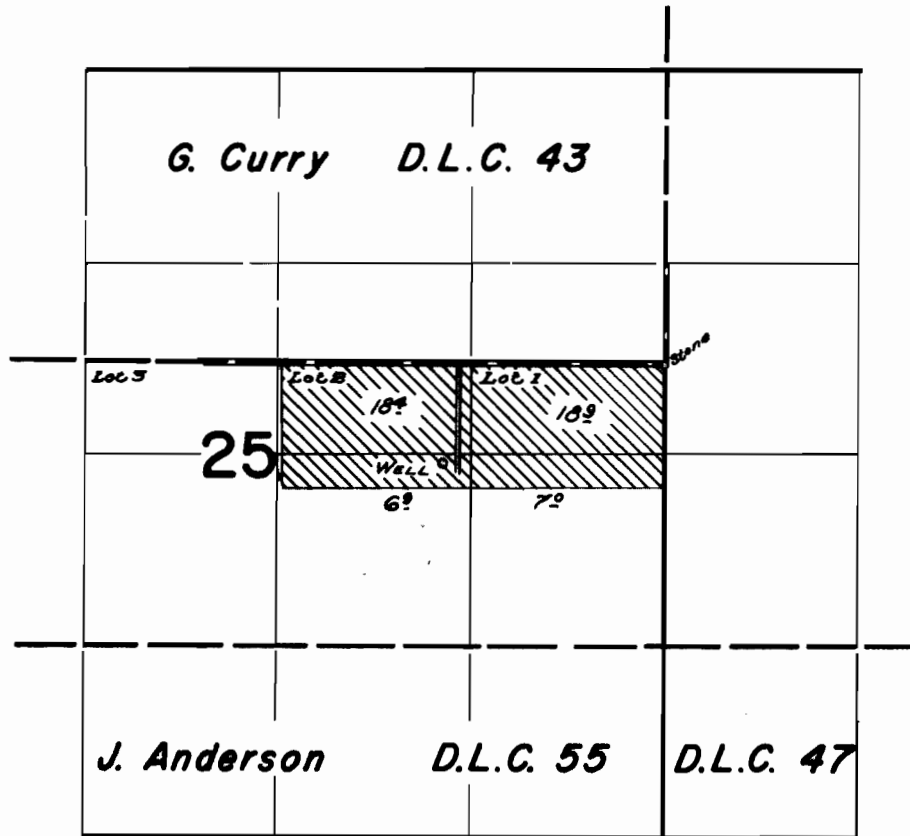

FINAL PROOF SURVEY
UNDER

Application No. G-1218 Permit No. G-966
IN NAME OF

CLACKAMAS COUNTY

Surveyed March 20, 1961, by *A. Jackson*