


# T.3S.R.2E.W.M.

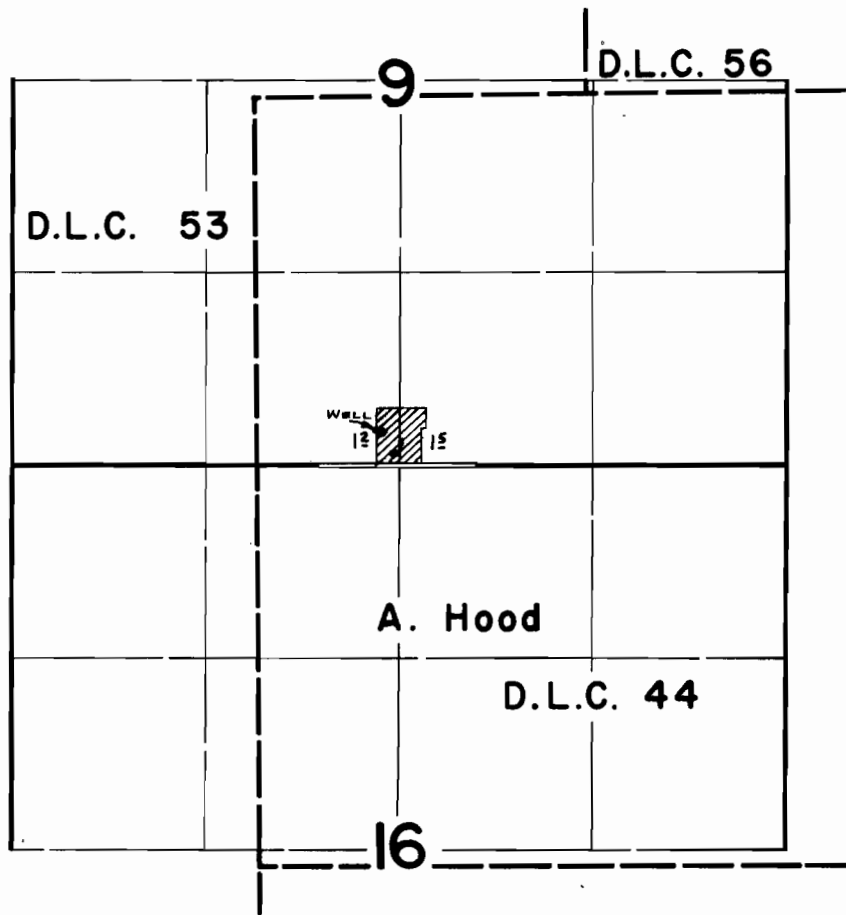

## FINAL PROOF SURVEY UNDER

Application No. G-704... Permit No. G-972...  
IN NAME OF

T. C. HAAG

Surveyed April 26 1961... by *R. Johnson*