


T. 2 S. R. 4 E. W. M.

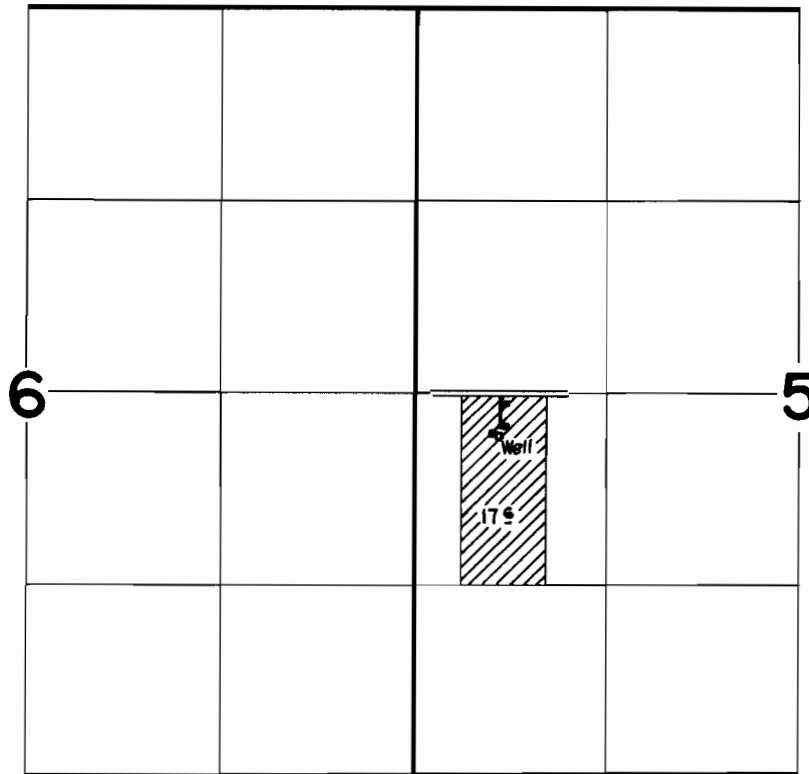

FINAL PROOF SURVEY
UNDER

Application No. **G-1097**... Permit No. **G-1036**...
IN NAME OF

KATSUMI MISHIMA

Surveyed May 31, 1961, by *[Signature]*