


# T.2S.R. 2 E.W.M.

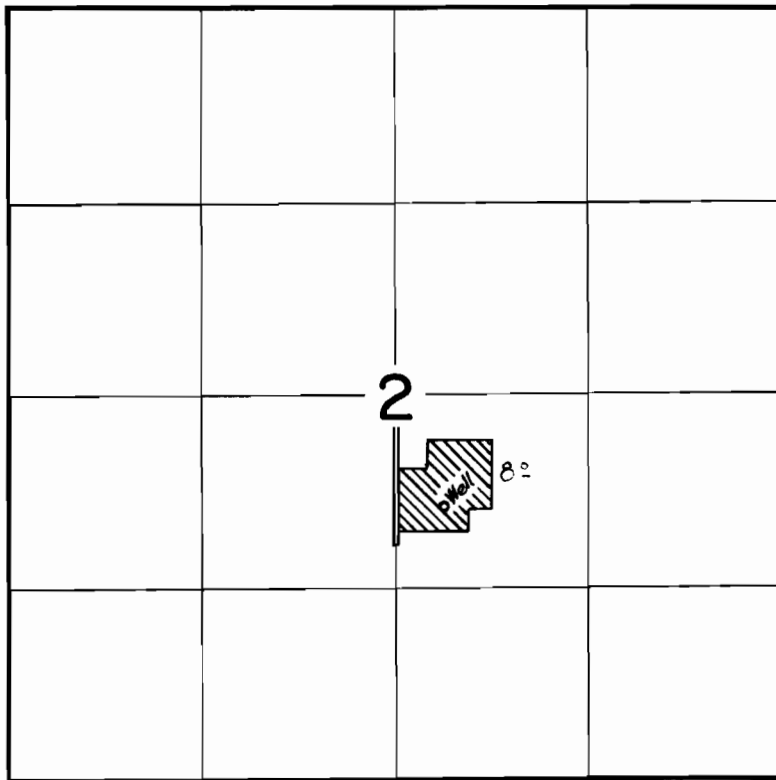

## FINAL PROOF SURVEY UNDER

Application No. **G-1262** Permit No. **G-1084**  
IN NAME OF

**GLENN N. SAVAGE, DBA RHODODENDRON NURSERY**

Surveyed April 5, 1961, by *[Signature]*