


T. 4 S. R. 1 E. W. M.

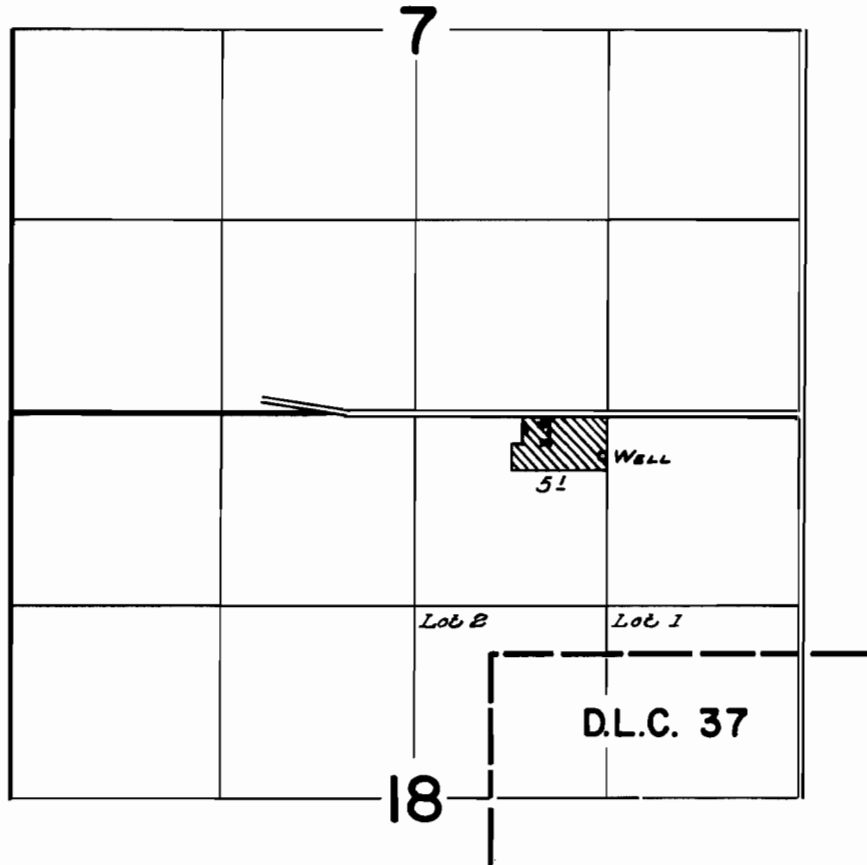

FINAL PROOF SURVEY UNDER

Application No. G-1556... Permit No. G-1444..
IN NAME OF

JOHN MITSCH

Surveyed March 24 1961., by

[Handwritten Signature]