


# T.2S.R.3E.W.M.

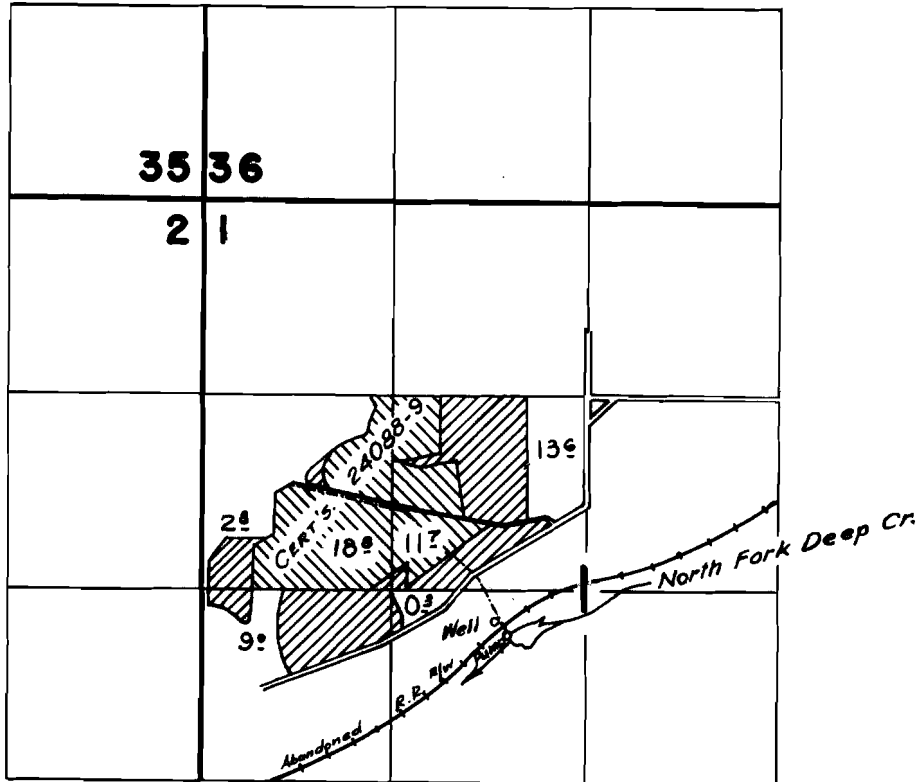

## FINAL PROOF SURVEY UNDER

Application No. ~~G-1642~~ Permit No. G-1500.  
IN NAME OF

.....MEIERS DAIRY.....

Surveyed April 6, 1961, by