


T. 4 S. R. 1 E. W. M.

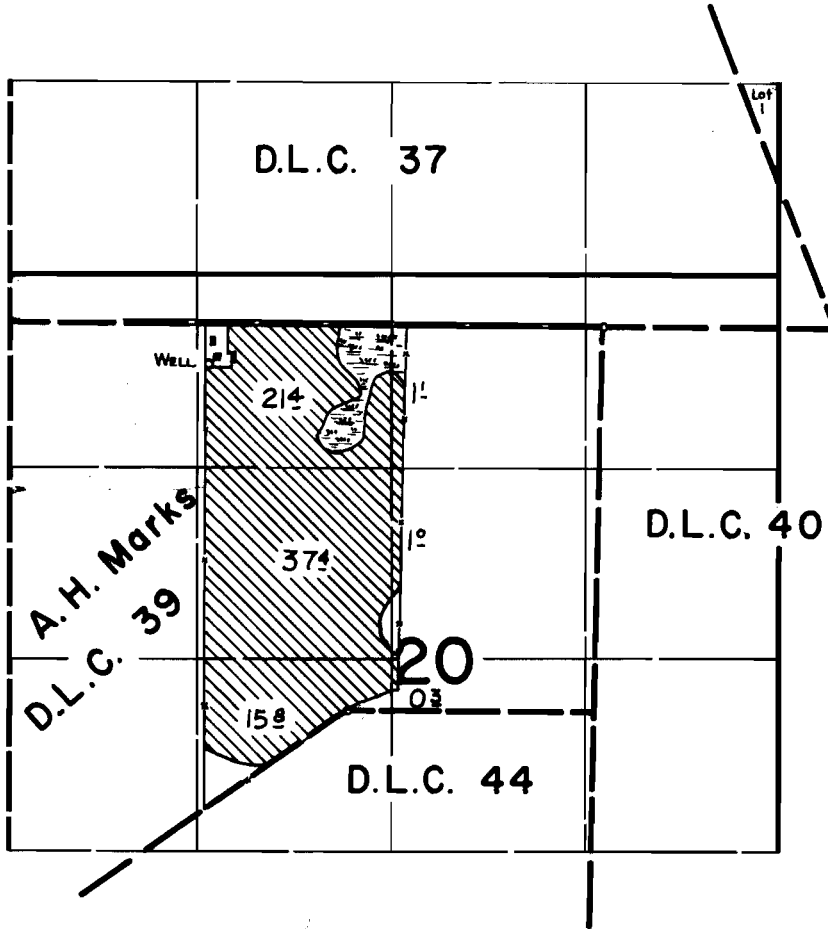

FINAL PROOF SURVEY UNDER

Application No. G-1784. Permit No. G-1838.
IN NAME OF

ROBERT W. MAY

Surveyed March 24 1961., by

[Handwritten signature]