


T.2S.R.2E.W.M.

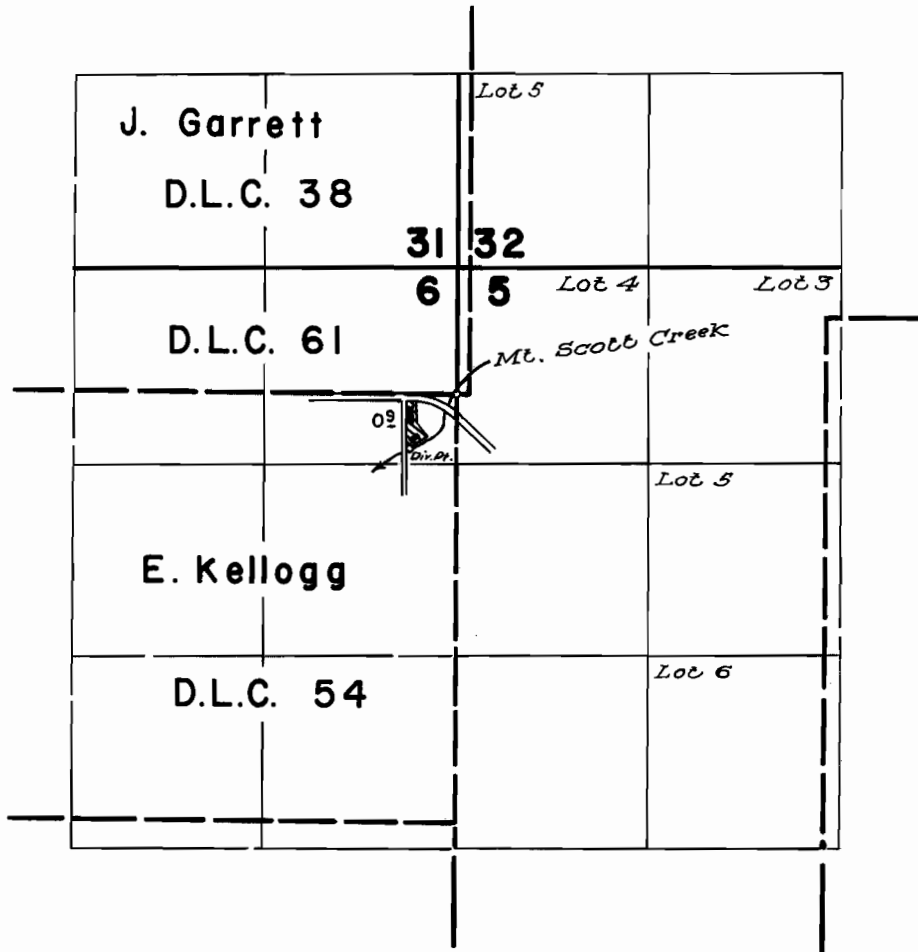

FINAL PROOF SURVEY UNDER

Application No. 28418 Permit No. 22272
IN NAME OF

C. G. WOODS

Surveyed April 4, 1961, by

R. H. Jackson