


T.4 S. R. 4 E. W. M.

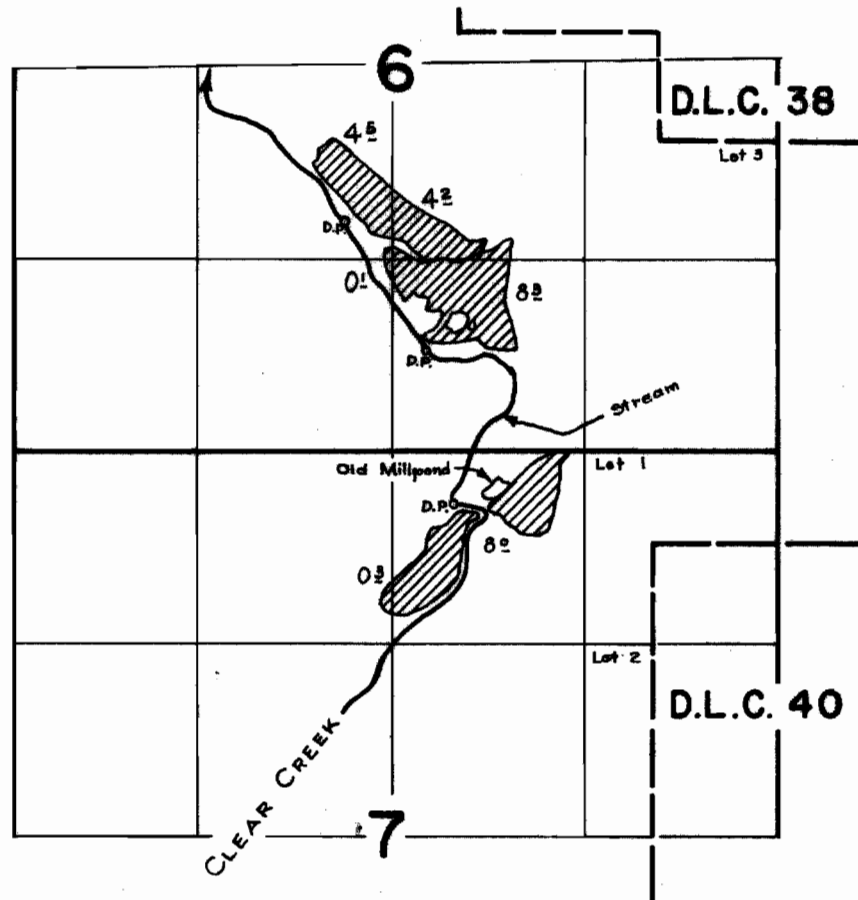

FINAL PROOF SURVEY
UNDER

Application No. 20392 Permit No. 22398
IN NAME OF

EVERETT A. SHIBLEY

Surveyed June 1, 1961, by *[Signature]*