


# T. 3 S. R. 3 E. W. M.

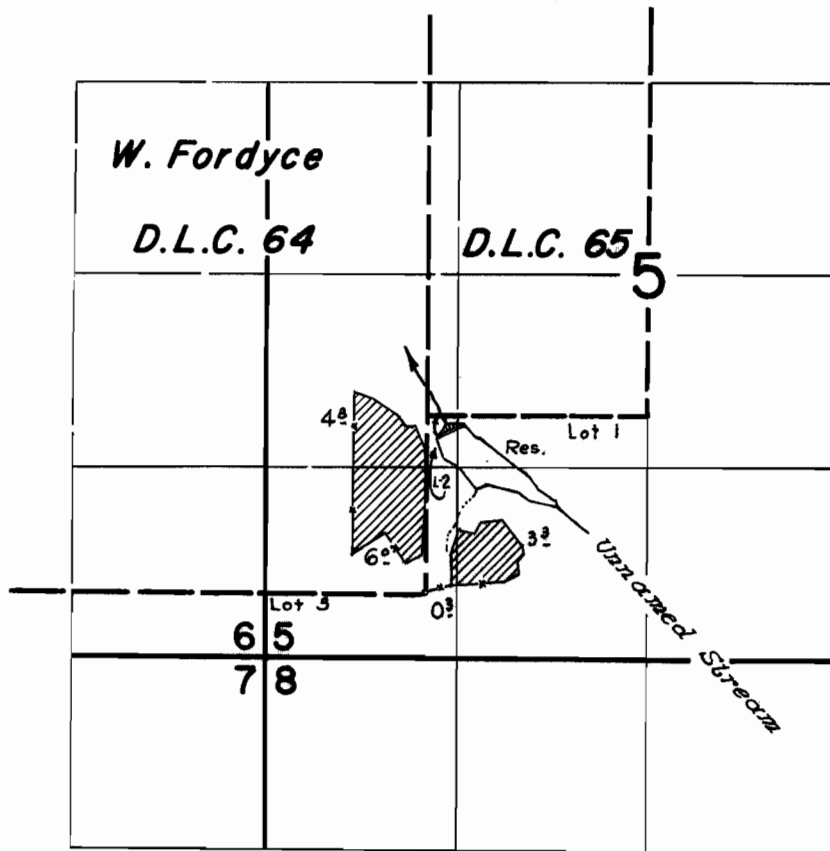

## FINAL PROOF SURVEY UNDER

R-29541                      R-1691  
Application No. 29542 Permit No. 23278  
IN NAME OF

ERVIN E. BRISCOE

Surveyed Sept. 6, 1961, by [Signature]