


T. 3 S. R. 3 E. W. M.

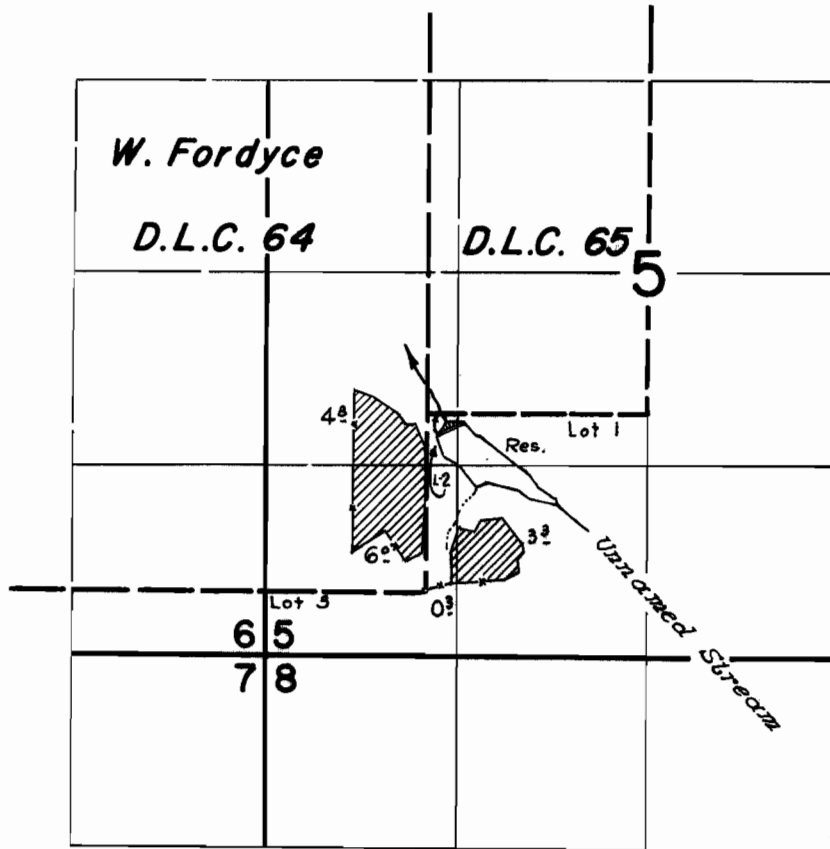

FINAL PROOF SURVEY UNDER

R-29541 R-1691
Application No. 29542 Permit No. 23278
IN NAME OF

ERVIN E. BRISCOE

Surveyed Sept. 6, 1961, by [Signature]