


T.3S.R.2E.W.M.

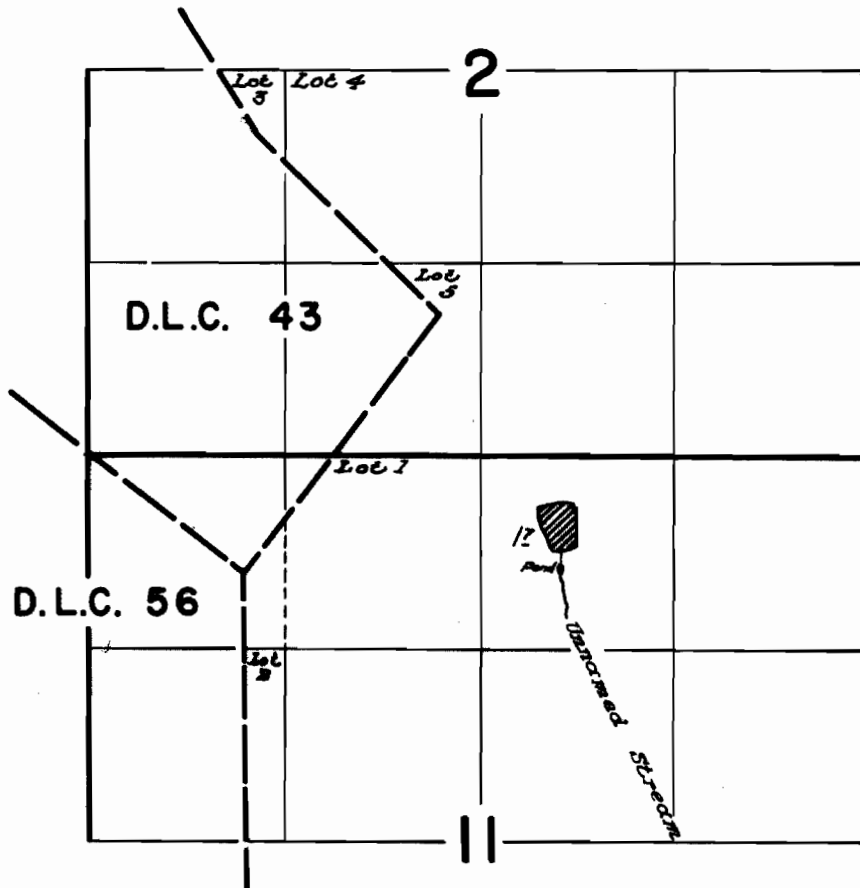

FINAL PROOF SURVEY
UNDER

Application No. 30716... Permit No. 24193...
IN NAME OF

H. L. MACK

Surveyed April 26 1961, by

R. H. Jackson