


T.3S.R.2E.W.M.

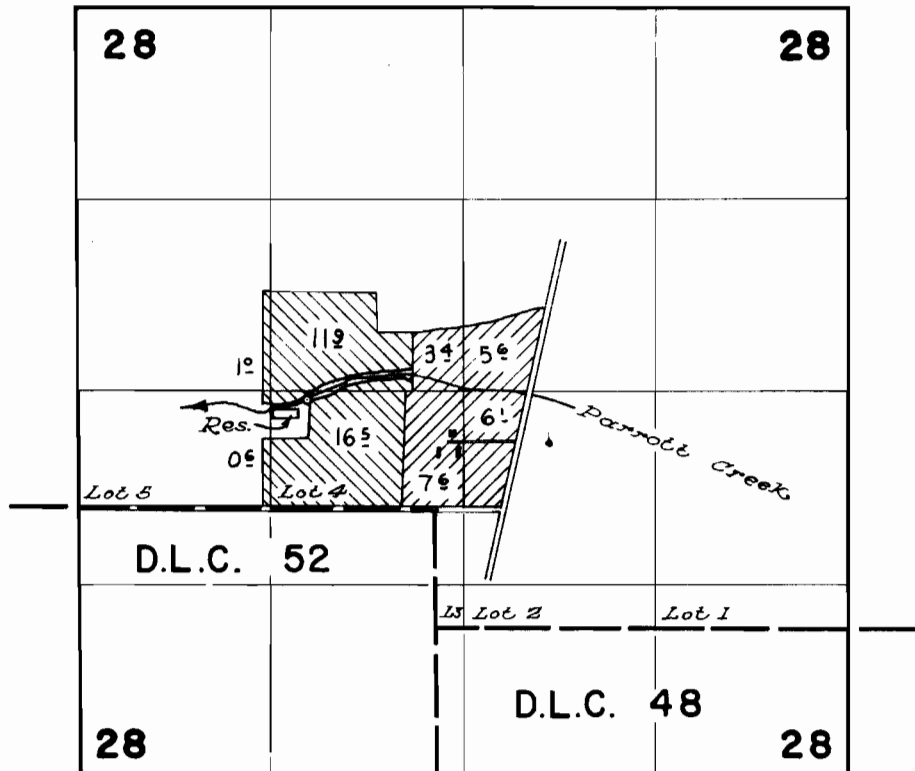

30817 
 32609 


FINAL PROOF SURVEY UNDER

R-30881 R-1892
 30817 24316
 Application No. 32609 Permit No. 25726...
 IN NAME OF

ELDON EVANS

Surveyed April 26 1961, by 

T. 3S. R. 2E. W.M.

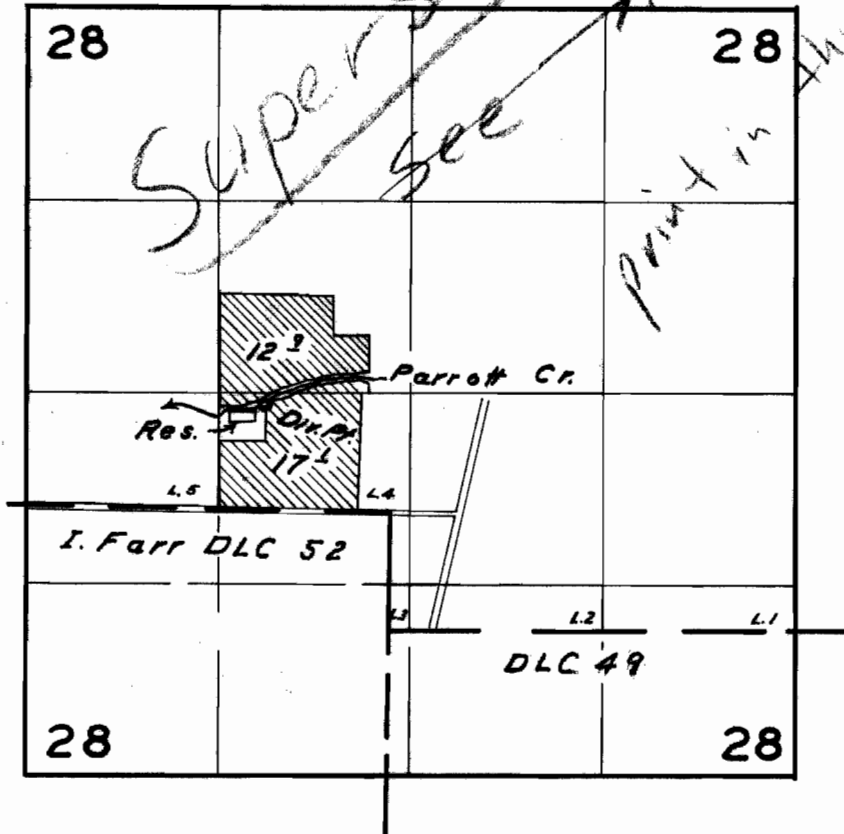

FINAL PROOF SURVEY
UNDER

R-30881 R-1892
Application No. 30817... Permit No. 24316...
IN NAME OF

Elden C. Evans

Surveyed July 3, 1958, by W. N. Perry