


T.5S.R.1W.&1E.W.M.

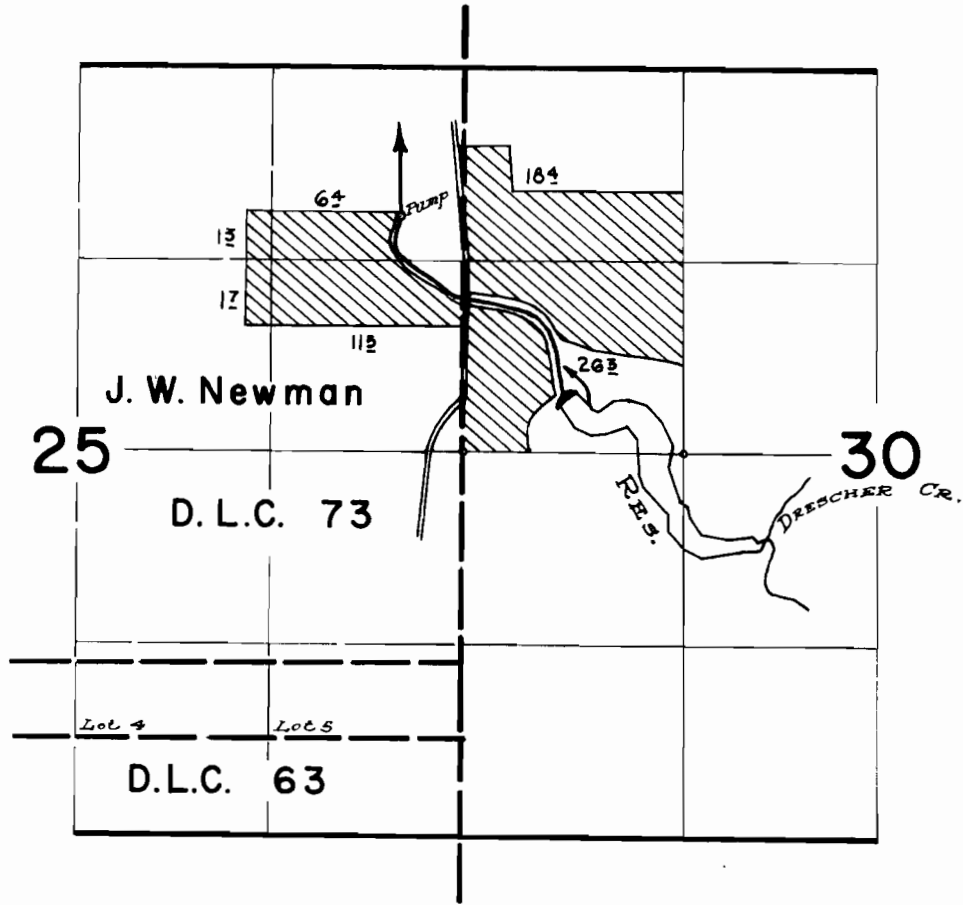

FINAL PROOF SURVEY
UNDER

R-31103 R-1943
Application No. 31104 Permit No. 24514...
IN NAME OF

JOHN DRESCHER

Surveyed March 21 1961, by *[Signature]*