


T.3S.R.1E.W.M.

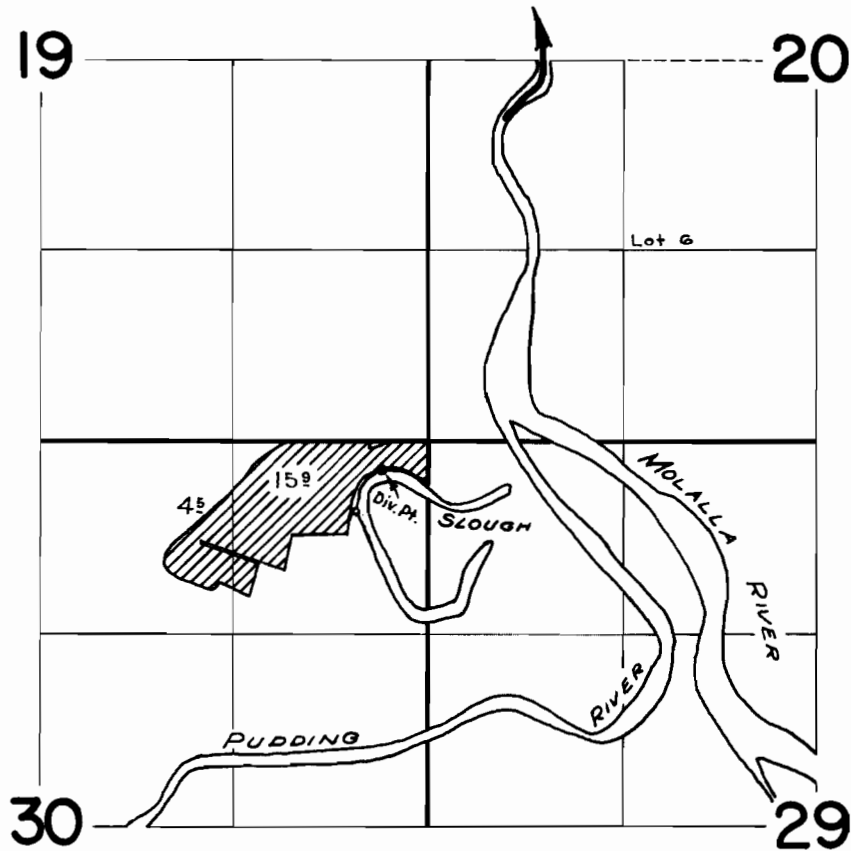

**FINAL PROOF SURVEY**  
UNDER

Application No. **31061**.... Permit No. **24541**....  
IN NAME OF

**GEORGE EILERS**

Surveyed June 2, 1961, by *A Jackson*