


T.4S.R.5E.W.M.

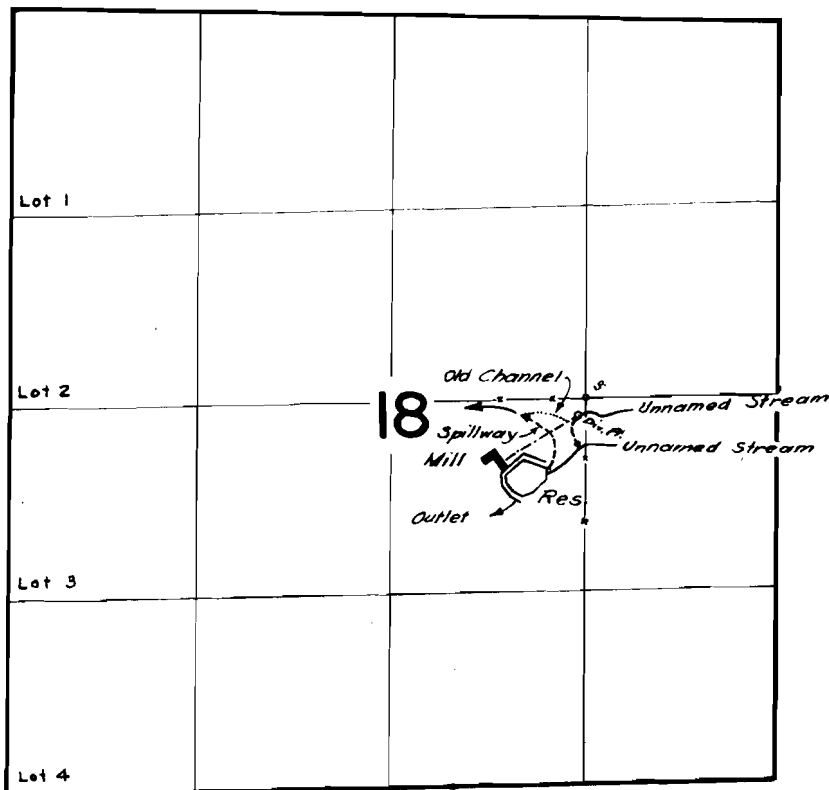

FINAL PROOF SURVEY
UNDER

Application No. **R-30553** **30554** Permit No. **R-1963** **24590**
IN NAME OF

A. H. LARSEN

Surveyed May 17 1961, by *Ed Jackson*