


T.3S.R.1E.W.M.

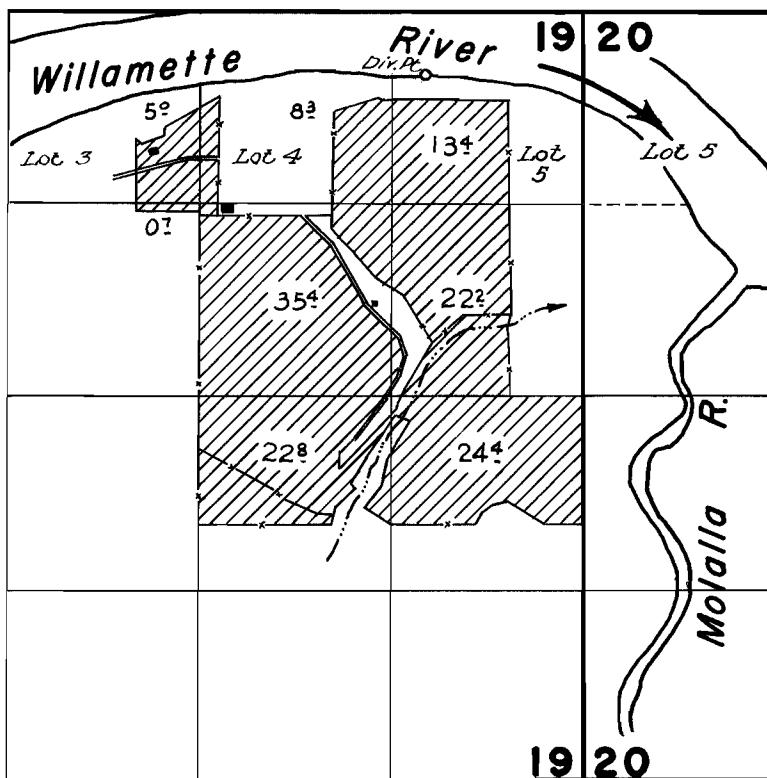

FINAL PROOF SURVEY UNDER

Application No. **31512** Permit No. **24858**
IN NAME OF

GEORGE F. & LEONA IRENE WEICKER

Surveyed Sept. 3 & 4 1959, by *[Signature]*