


T.2S. R.4 E.W.M.

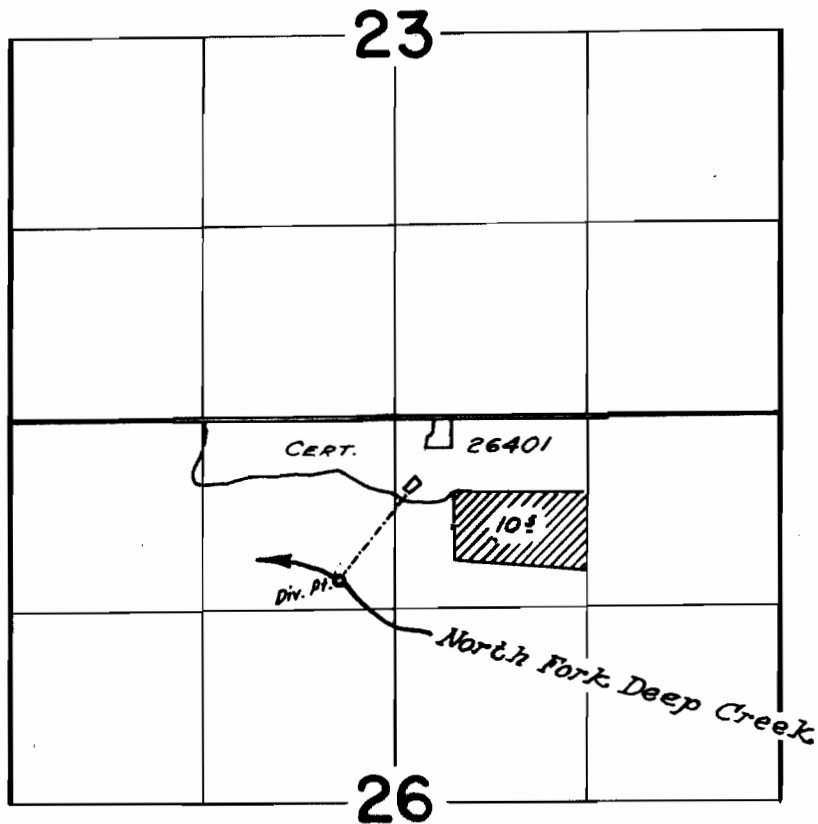

FINAL PROOF SURVEY
UNDER

Application No. 31143 Permit No. 24251
IN NAME OF

J. A. VON BERGEN

Surveyed April 25 1961, by [Signature]