


T.2S.R.2E.W.M.

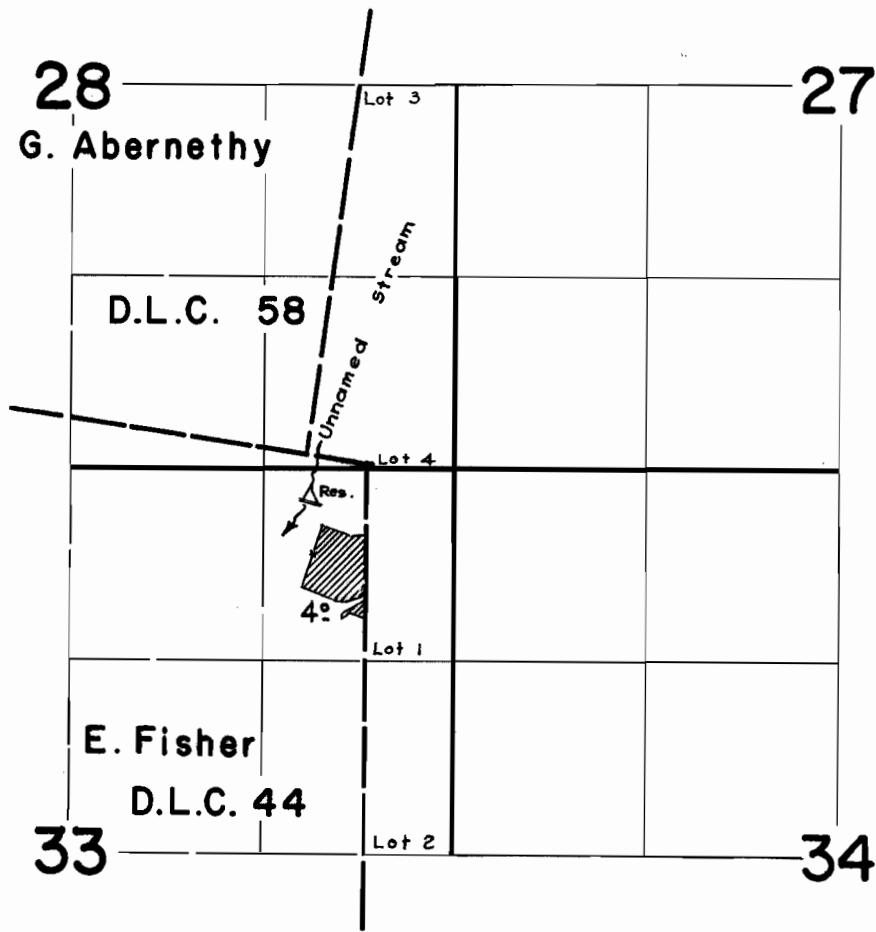


FINAL PROOF SURVEY
UNDER

R-31520 R-2048
Application No. 31435 Permit No. 25020
IN NAME OF

HERBERT H. HEMPHILL

Surveyed May 19, 1961, by *A. J. [Signature]*

T.2S.R.2E.W.M.

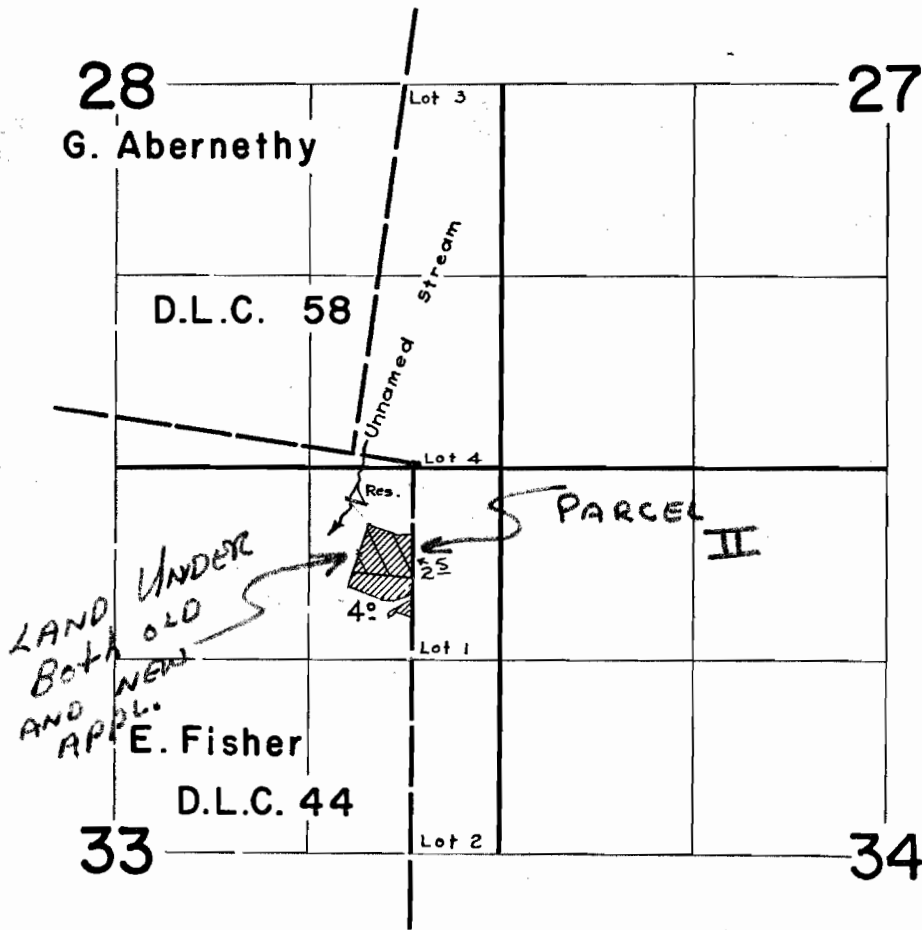

FINAL PROOF SURVEY
UNDER

R-31520 R-2048
Application No. 31435... Permit No. 25020
IN NAME OF

HERBERT H. HEMPHILL

Surveyed May 19, 1961, by *A. Jackson*