


T. 4S. R. 1 W. W.M.

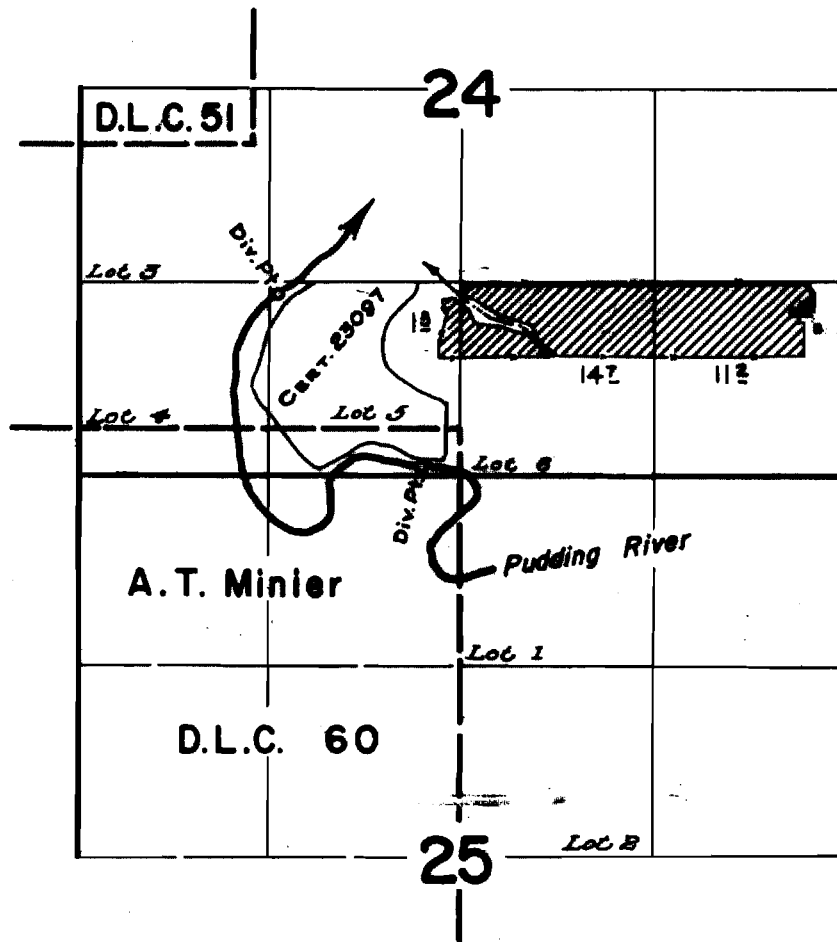

FINAL PROOF SURVEY UNDER

Application No. ~~32132~~ Permit No. 25352
IN NAME OF

HAZEL PREUITT

Surveyed March 23, 1961, by