


T.3S.R.4E.W.M.

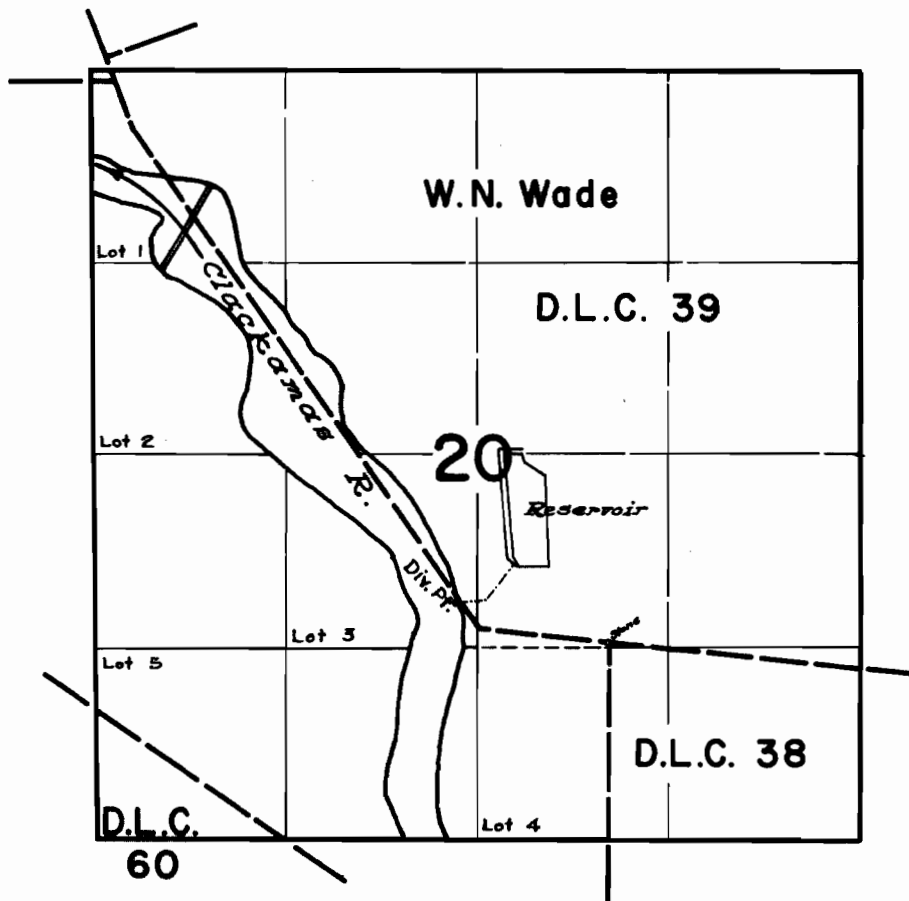

**FINAL PROOF SURVEY**  
UNDER

Application No. <sup>R-32094</sup>~~32095~~ Permit No. <sup>R-2112</sup>~~25309~~  
IN NAME OF

**PARK LUMBER CO. INC.**

Surveyed May 16, 1961, by *R. Jackson*