


T. 2S. R. 3E. W.M.

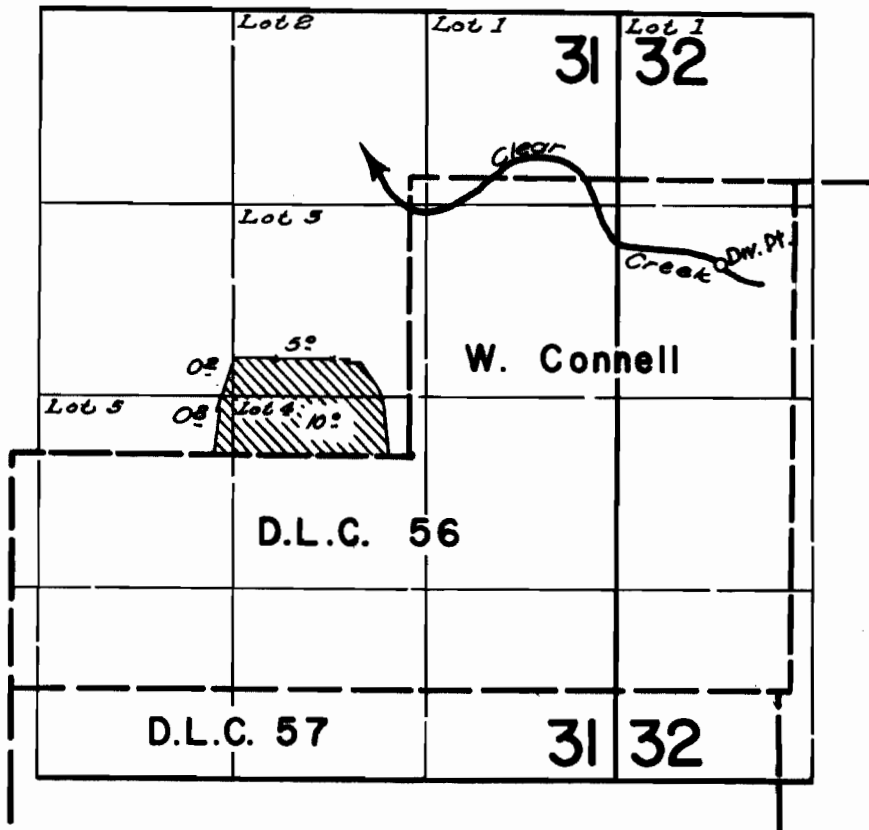

FINAL PROOF SURVEY
UNDER

Application No. ~~32184~~ Permit No. 25375...
IN NAME OF

JOHN F. DEININGER

Surveyed April 7, 1961, by

Appelton