


T.2S. R.4E.W.M.

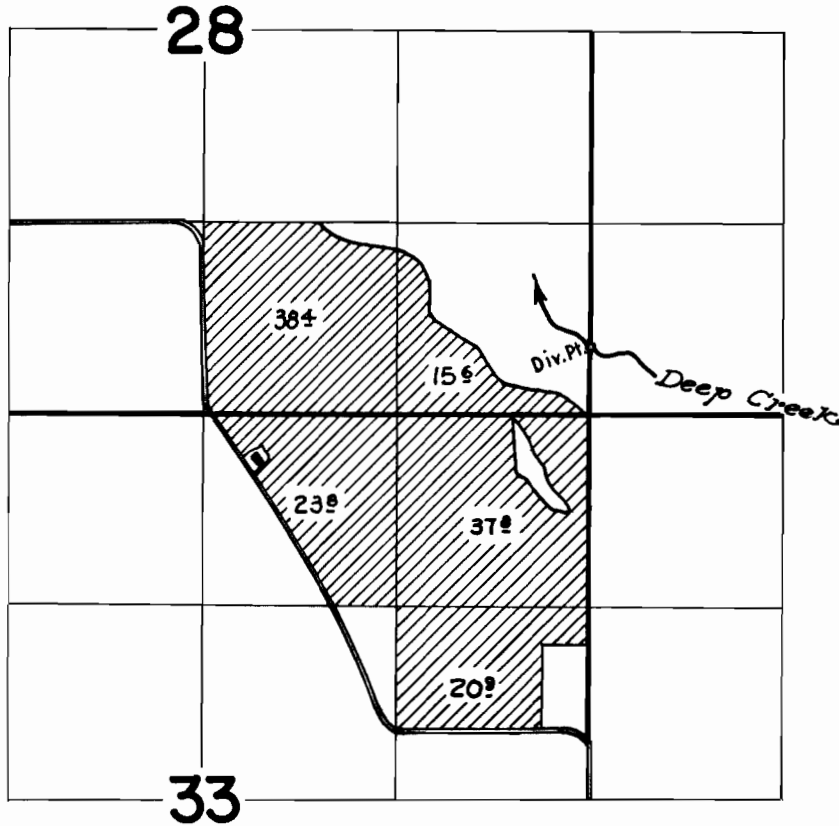

**FINAL PROOF SURVEY**  
UNDER

Application No. **32154**... Permit No. **25408**...  
IN NAME OF

**ROBERT WAYNE JUDD**

Surveyed May 31, 1961., by

*[Signature]*