


T.2S.R.2E.W.M.

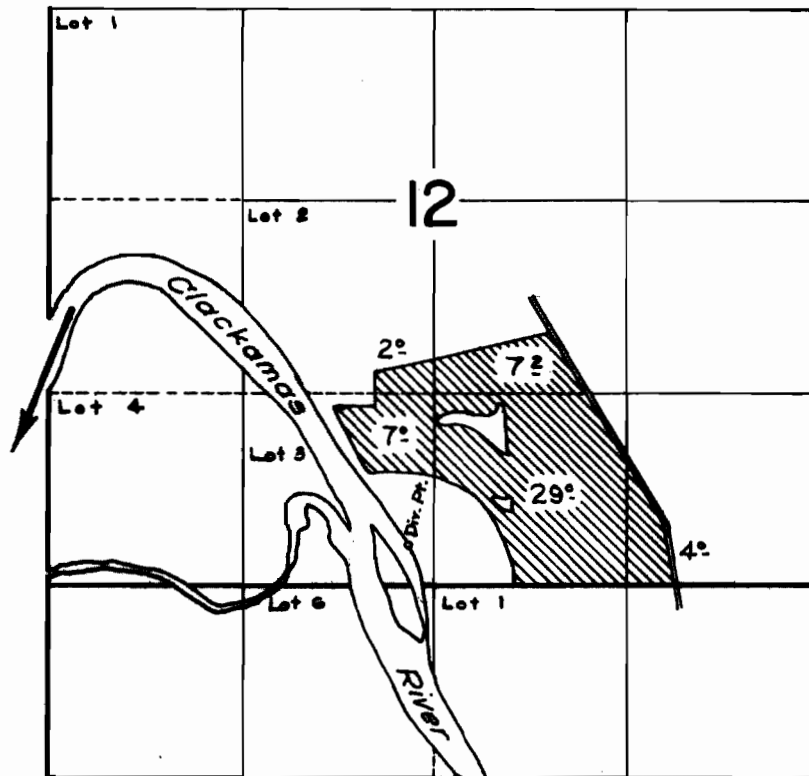

FINAL PROOF SURVEY UNDER

Application No. **32253**... Permit No. **25481**...
IN NAME OF

HOWARD S. JANSIK

Surveyed **Sept. 6, 1961**., by *[Signature]*