


T.2S.R.2E.W.M.

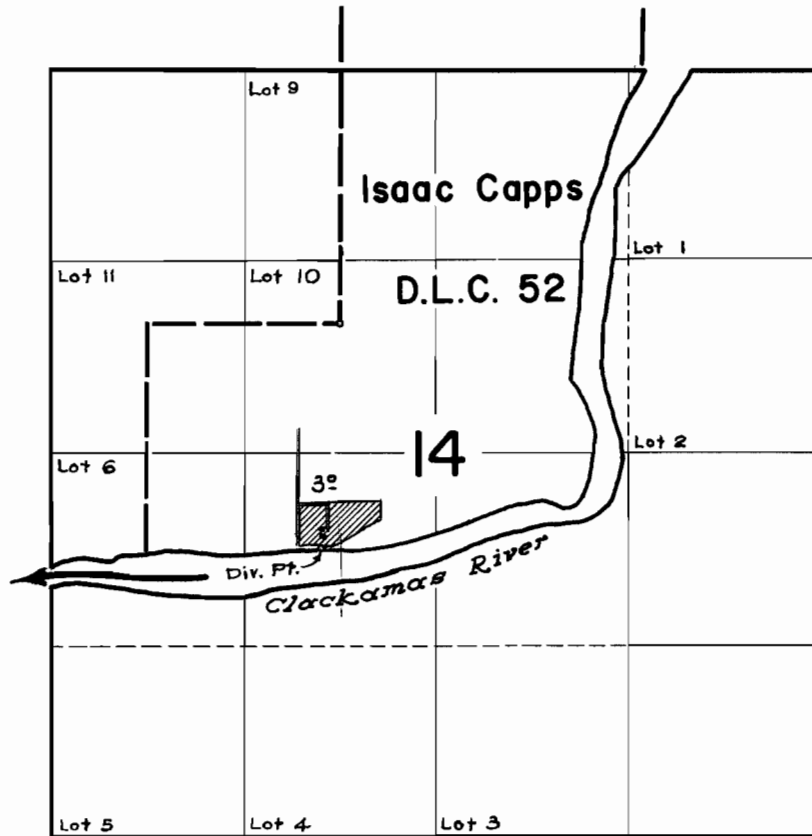

FINAL PROOF SURVEY
UNDER

Application No. 32841 Permit No. 26.0.0.0
IN NAME OF

WILLARD L. MATHIESEN

Surveyed May 18 1961, by [Signature]