


T.3S.R.5E.W.M.

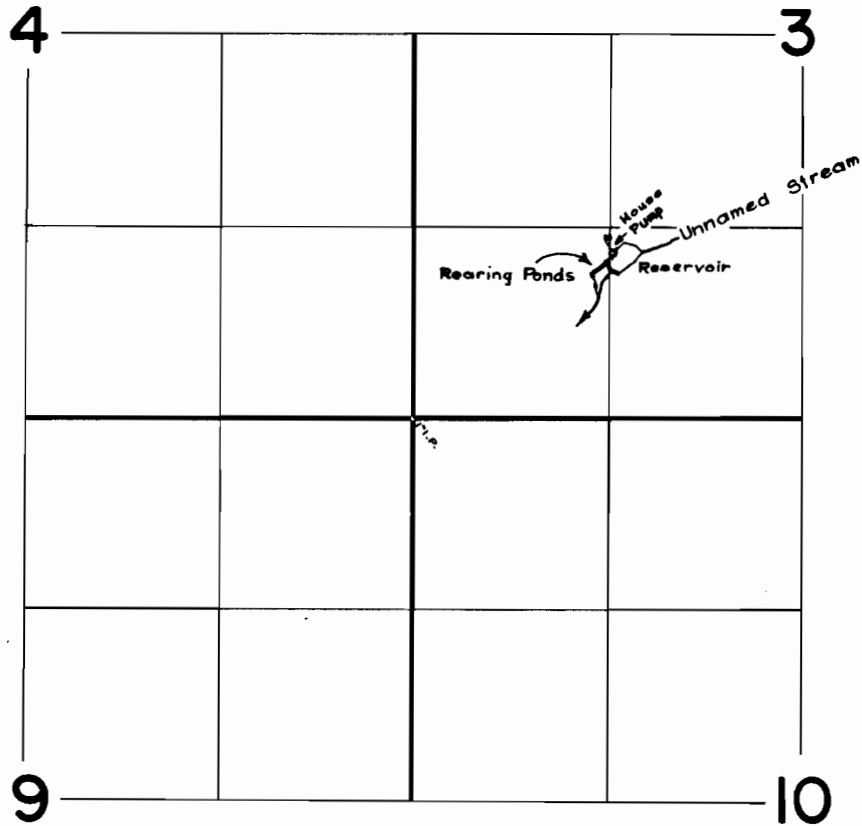

FINAL PROOF SURVEY
UNDER

R-32593 R-2174
32594 25723
Application No. 32959 Permit No. 26065
IN NAME OF

LAWSON G. BRIAN

Surveyed May 18, 1961, by R. H. Jackson