


T.6S.R.1E.W.M.

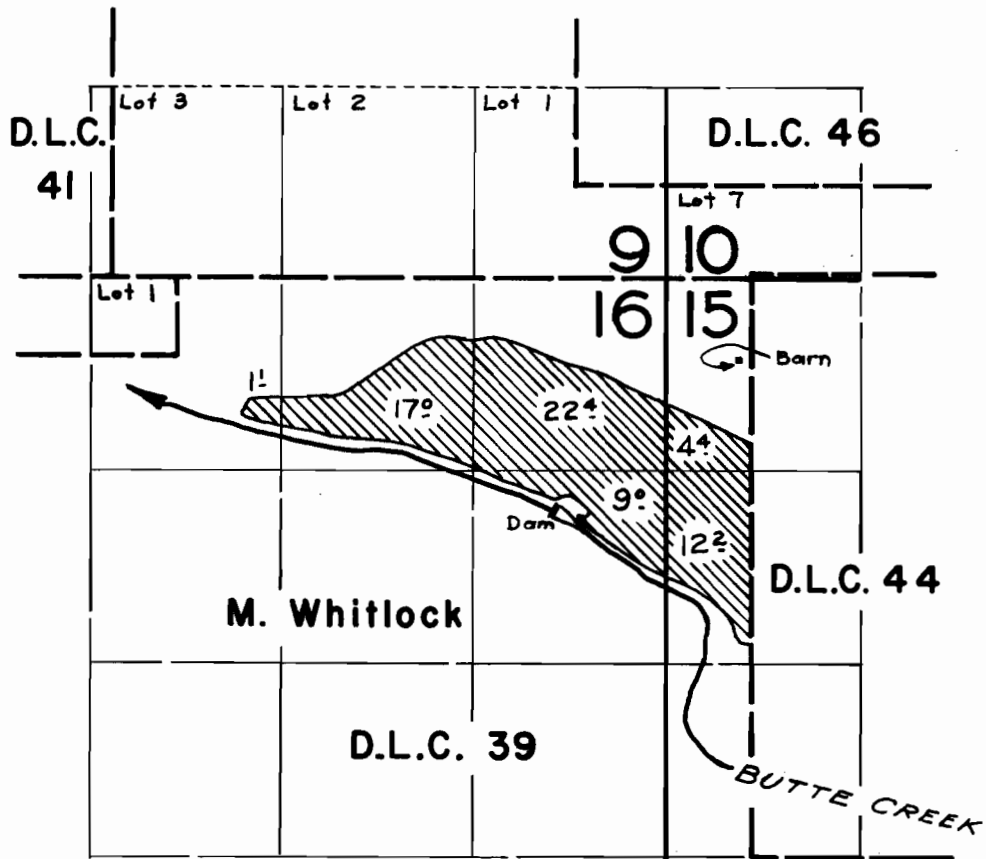

**FINAL PROOF SURVEY**  
UNDER

Application No. 32865 Permit No. 25959  
IN NAME OF

HARVEY KASER

Surveyed June 1, 1961, by

*A. Jackson*