


# T.5S. R.2E.W.M.

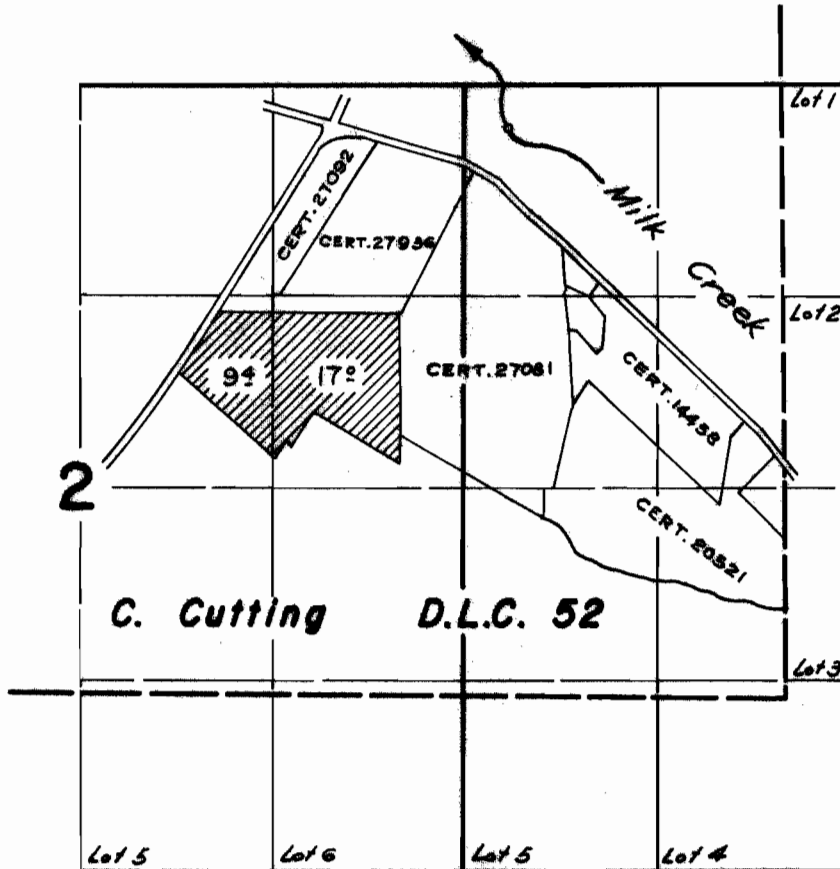

## FINAL PROOF SURVEY UNDER

Application No. ~~33981~~ Permit No. ~~29869~~  
IN NAME OF

**FRANK RUSSELL**

Surveyed May 16, 1961, by *R. Jackson*