


T.2S.R.4E.W.M.

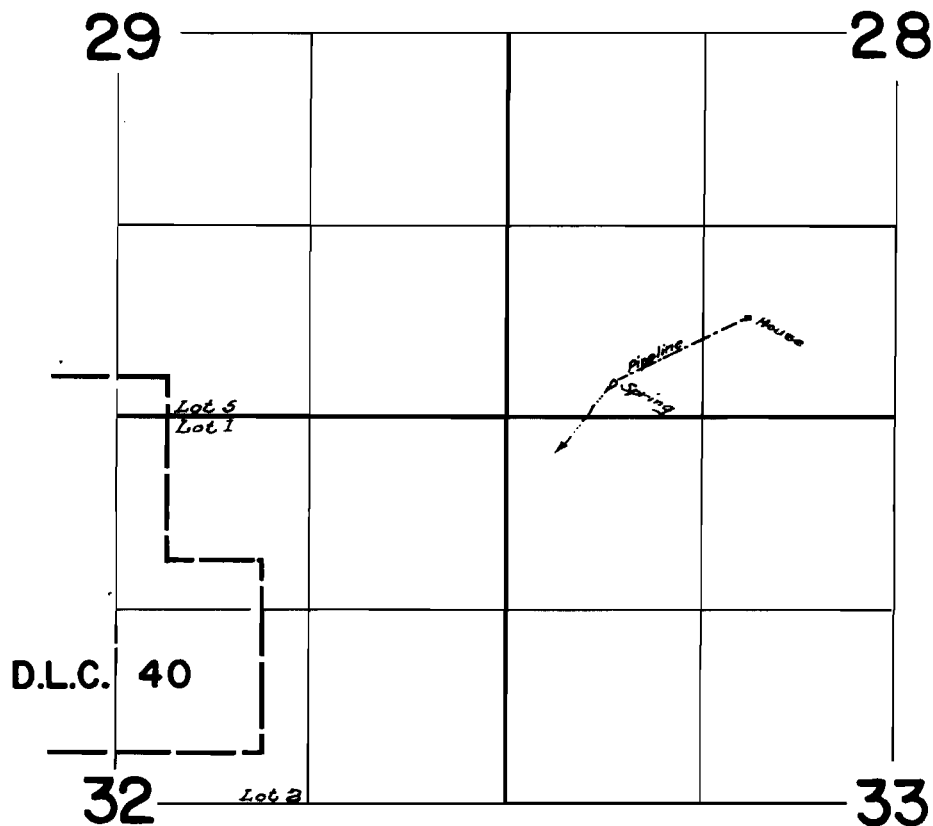

FINAL PROOF SURVEY
UNDER

Application No. **34239** Permit No. **26999**
IN NAME OF

FRANK A. TACHERON

Surveyed April 25 1961, by *R. H. H. H. H.*