


T.22S.R.9W.W.M.

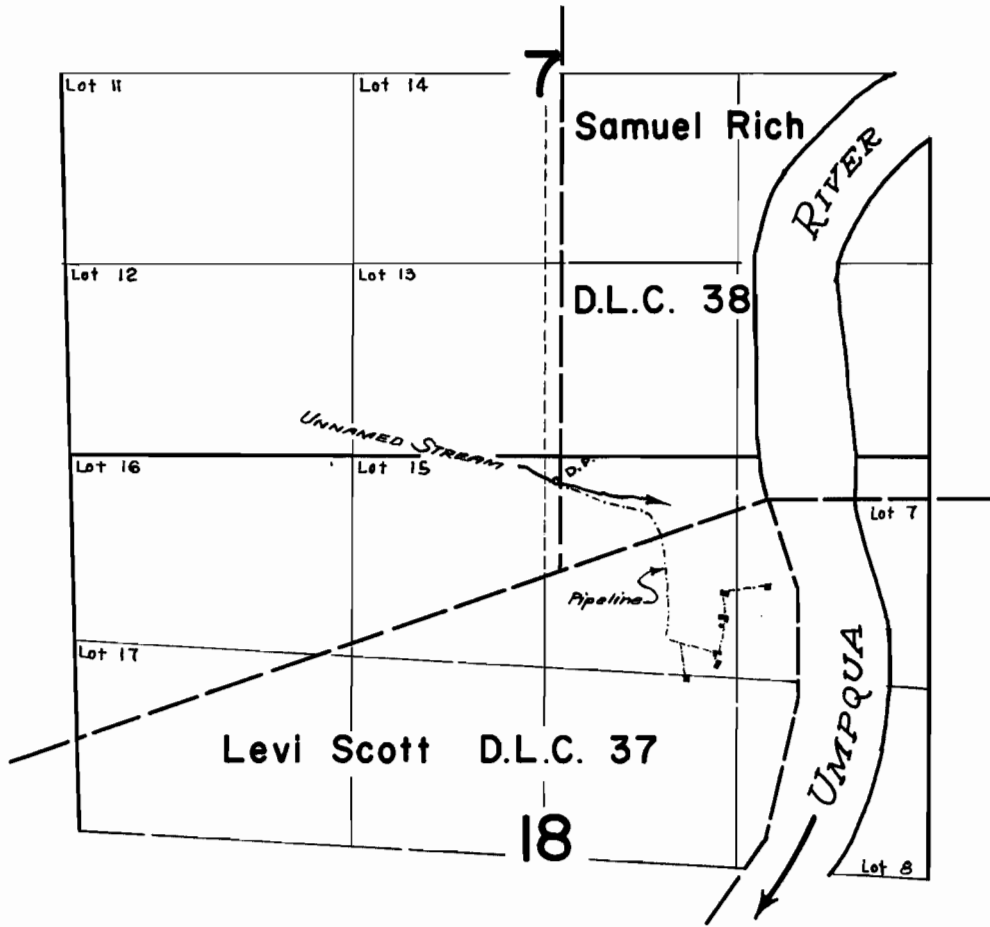

**FINAL PROOF SURVEY**  
UNDER

Application No. 23295 Permit No. 18435  
IN NAME OF

ESTATE OF PAUL WESSELA

Surveyed March 28 1961, by *[Signature]*