


T.30S.R.5W.W.M.

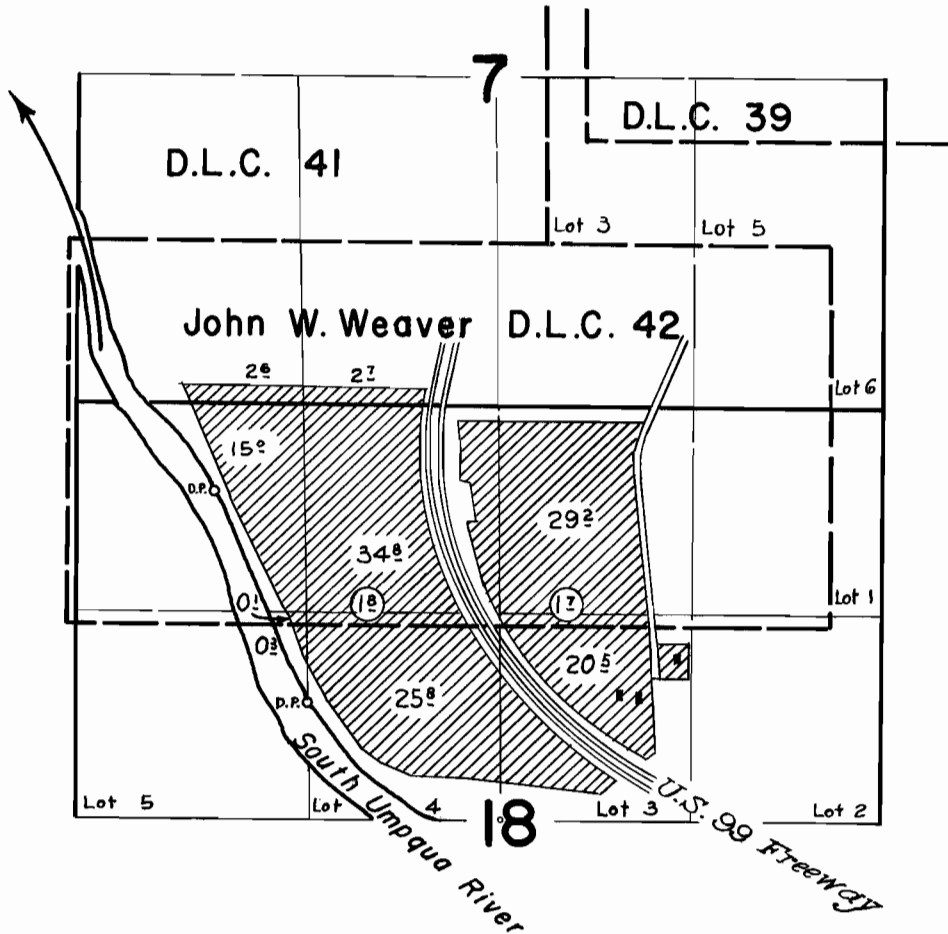

Note: D.L.C. & Section Lines are Located
from Douglas County Records

FINAL PROOF SURVEY
UNDER

Application No. 28241... Permit No. 22210...
IN NAME OF

WM. P. WEAVER

Surveyed July 21, 1961, by *A. Jackson*