


T.23S.R.10W.W.M.

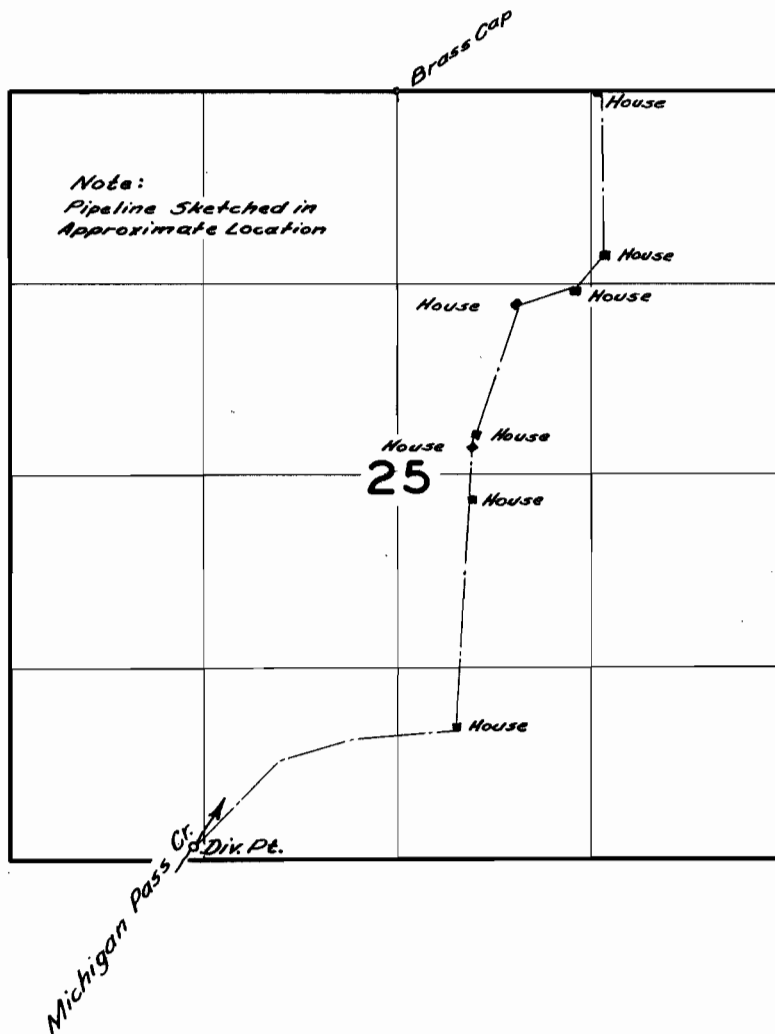

FINAL PROOF SURVEY
UNDER

Application No. 29442 Permit No. 23177
IN NAME OF

Helen M. Judy, et al

Surveyed June 29 1960, by C.D. Bantle