


T.28S.R.5W.W.M.

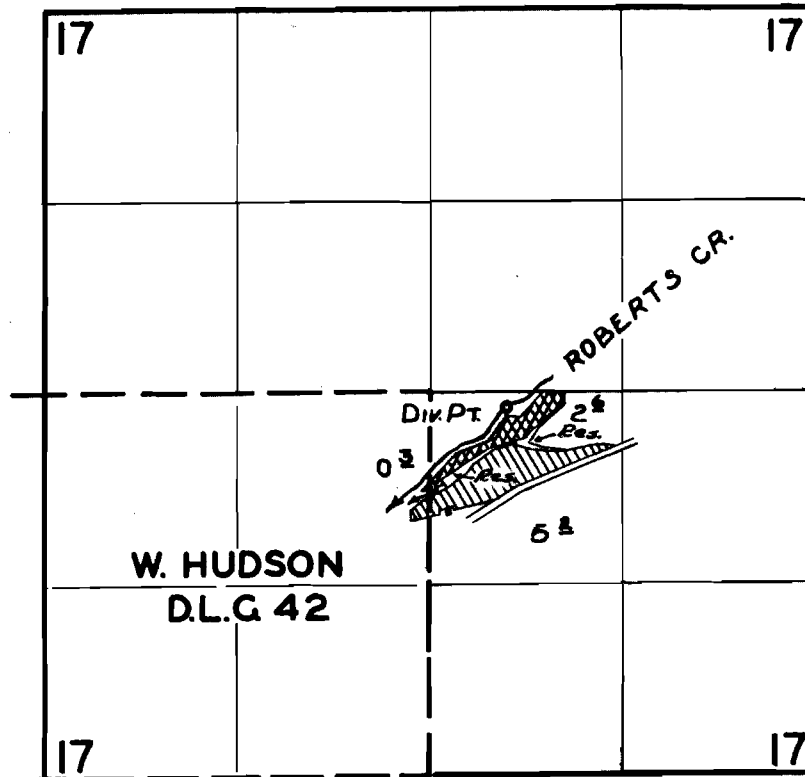

 FROM CR. & RES.

 FROM RES.

FINAL PROOF SURVEY
UNDER

R-29760 R-1762
Application No. 28683.. Permit No. 23666..
IN NAME OF

.....THOMAS MELTON.....

Surveyed MAY 2, 1961., by G.D. BARTELS.