


T.28S.R.5W.W.M.

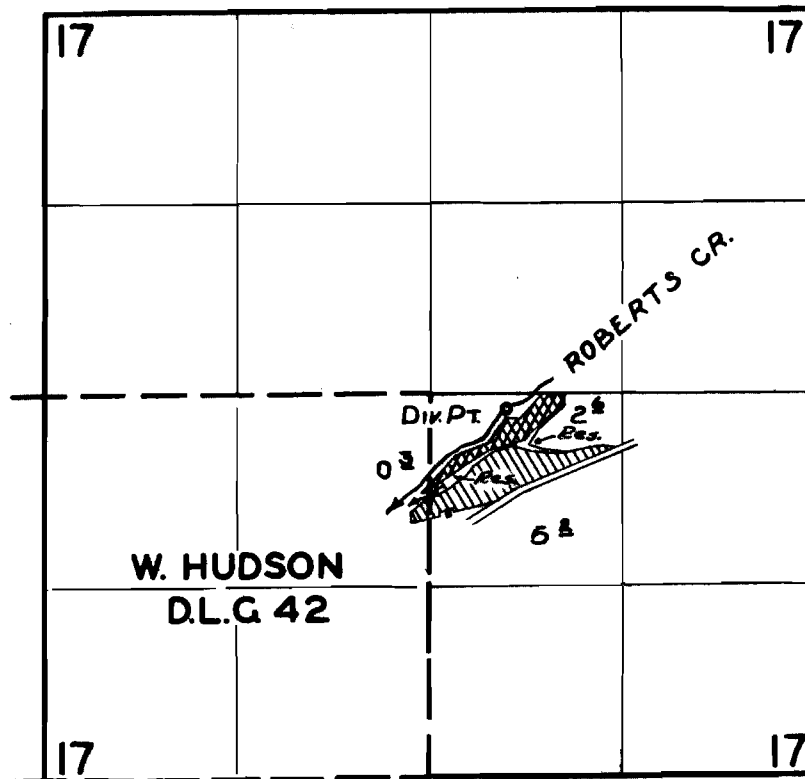

 FROM CR. & RES.

 FROM RES.

**FINAL PROOF SURVEY**  
UNDER

R-29760                      R-1762  
Application No. 28683.. Permit No. 23666..  
IN NAME OF

.....THOMAS MELTON.....

Surveyed MAY 2, 1961, by G.D. BARTELS.