


T.27S.R.7W.W.M

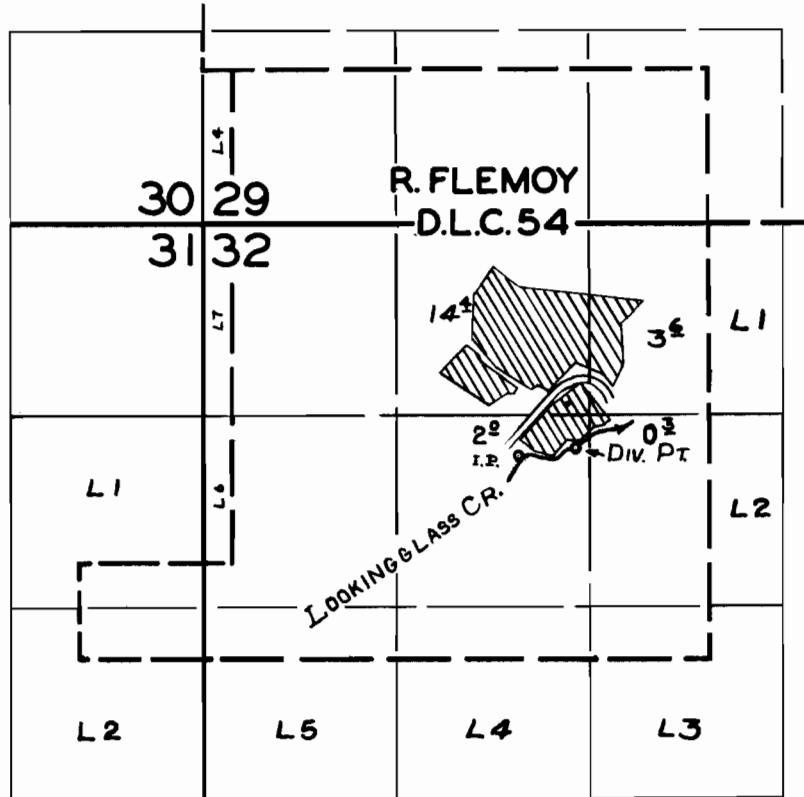

FINAL PROOF SURVEY UNDER

Application No. 306.53 Permit No. 24.172
IN NAME OF

RUSSELL E. DENZEL

Surveyed Mar. 1 1961, by C. O. BARTELS