


T.25S. R.5W.W.M.

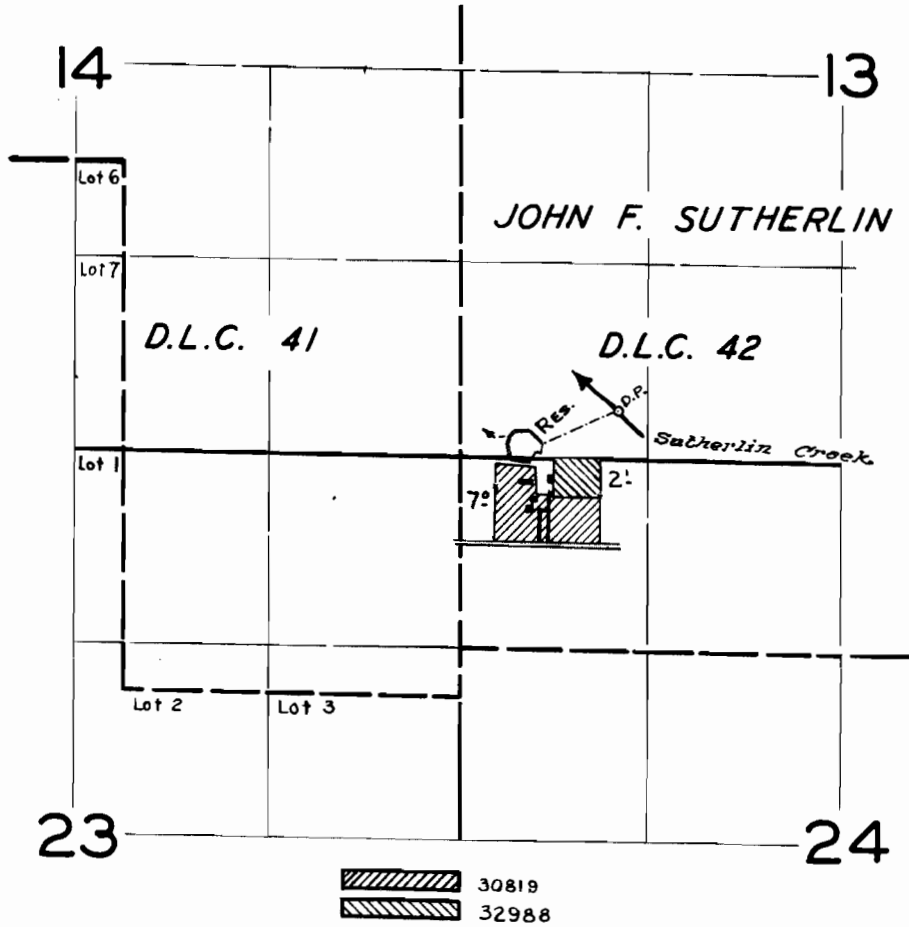

FINAL PROOF SURVEY
UNDER

R-30818 R-1873
30819 24260
Application No. 32988 Permit No. 26087
IN NAME OF

IVAN E. HOLM

Surveyed March 27 1961, by *A. Jackson*