


T.27S. R.6W.W.M.

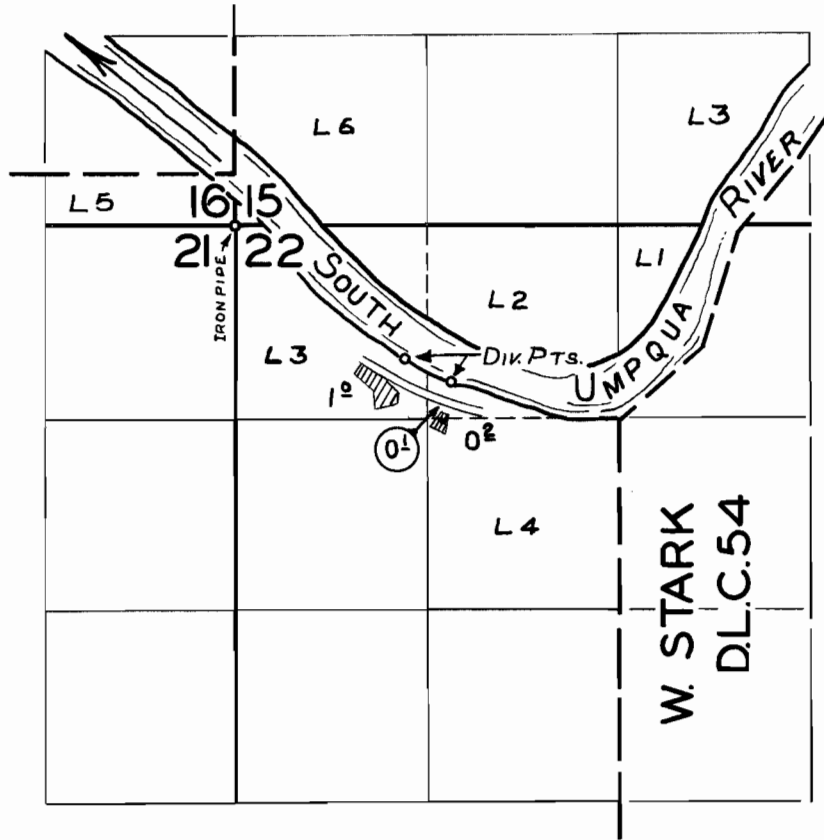

FINAL PROOF SURVEY
UNDER

Application No. 31374... Permit No. 24736.
IN NAME OF

BEN B. IRVING & GEORGE H. RIGGS

Surveyed *MAY 2*, 1961, by *C.O. BARTELS*.

