


T.28S.R.6W.W.M.

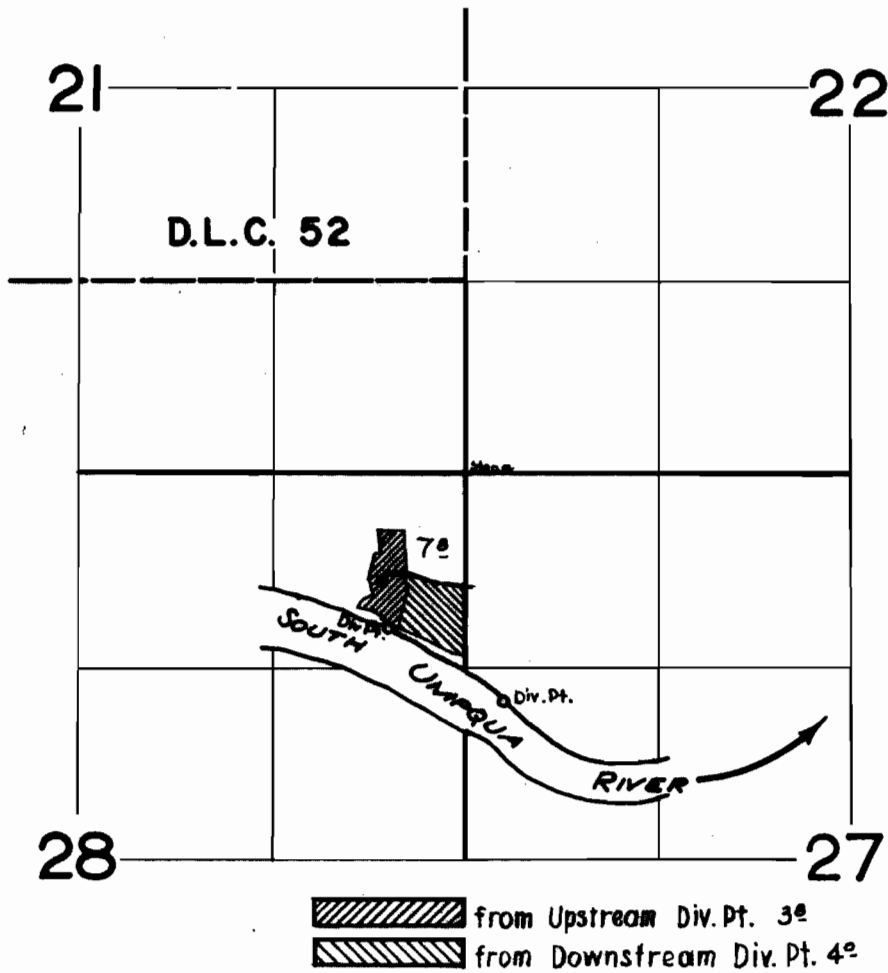

FINAL PROOF SURVEY
UNDER

Application No. ~~31262~~ Permit No. 25216...
IN NAME OF

THOMAS PARKINSON

Surveyed July 19 1961, by *P. Jackson*