


T.22S. R.8 W.W.M.

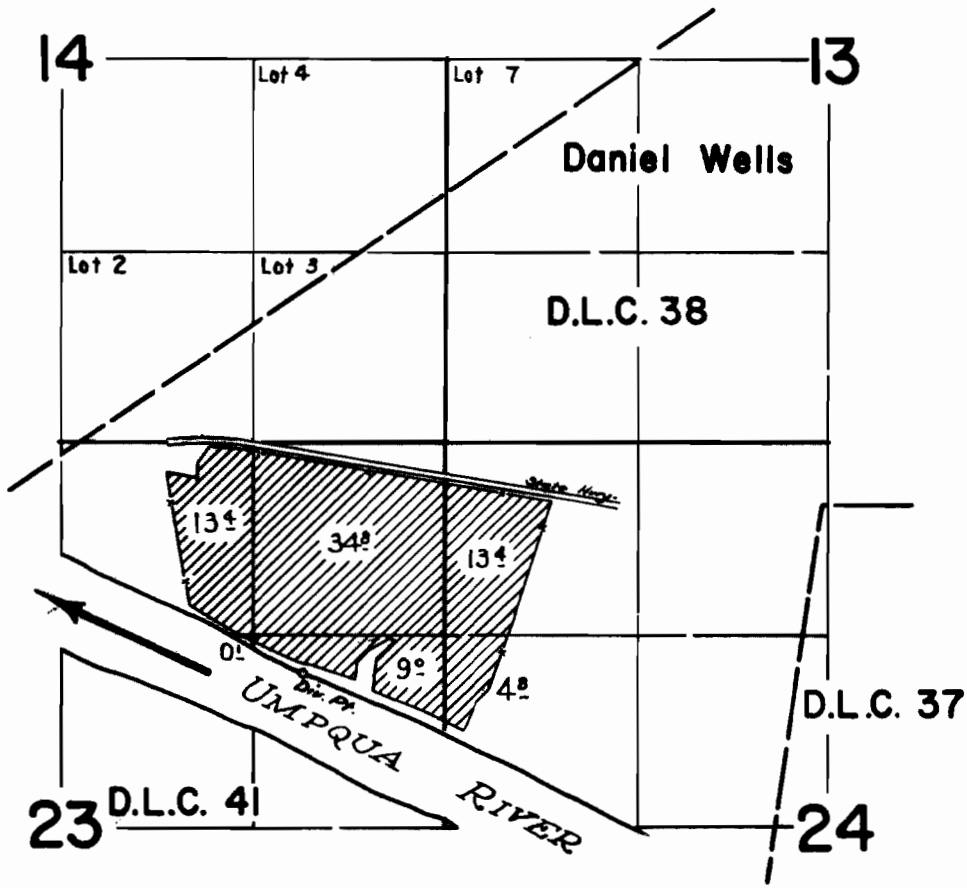

FINAL PROOF SURVEY
UNDER

Application No. 32195... Permit No. 25397...
IN NAME OF

JAMES R. & MARJORIE J. BOBST

Surveyed Mar. 30, 1961., by R. Jackson