


T.28S.R.7W.W.M.

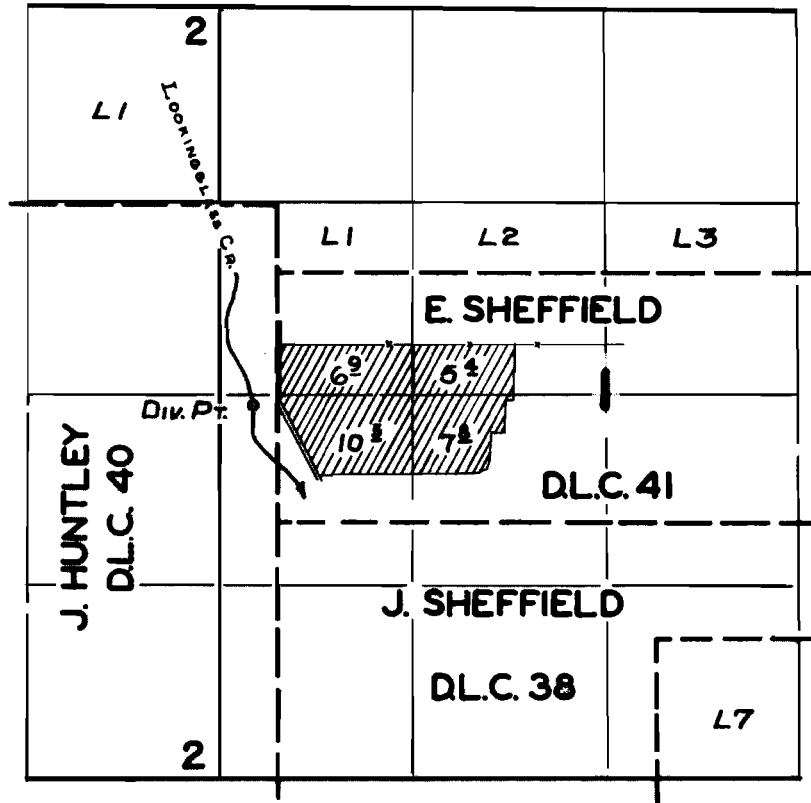

**FINAL PROOF SURVEY**  
UNDER

Application No. 32179... Permit No. 25386..  
IN NAME OF

.....*RUDOLPH H. MEYER*.....

Surveyed *MAY 2* 1961, by *C.O. BARTELS*..