


T.22S.R.5 W.W.M.

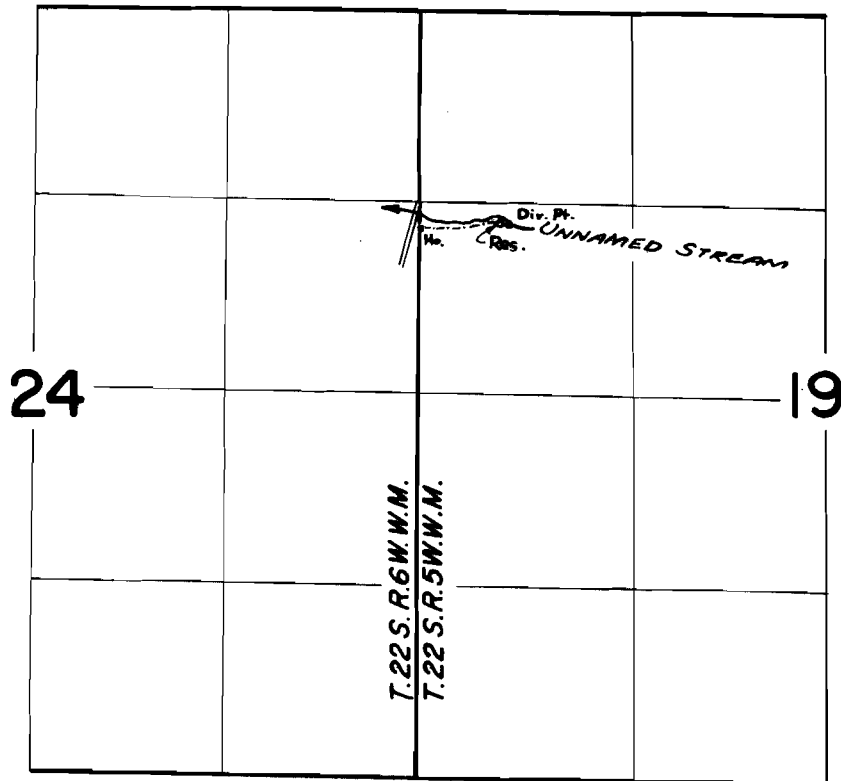

FINAL PROOF SURVEY UNDER

Application No. 32.573... Permit No. 25.713.....
IN NAME OF

SHIRLEY E. DRESSER

Surveyed Mar. 29, 1961, by