


T.29S.R. 8W.W.M.

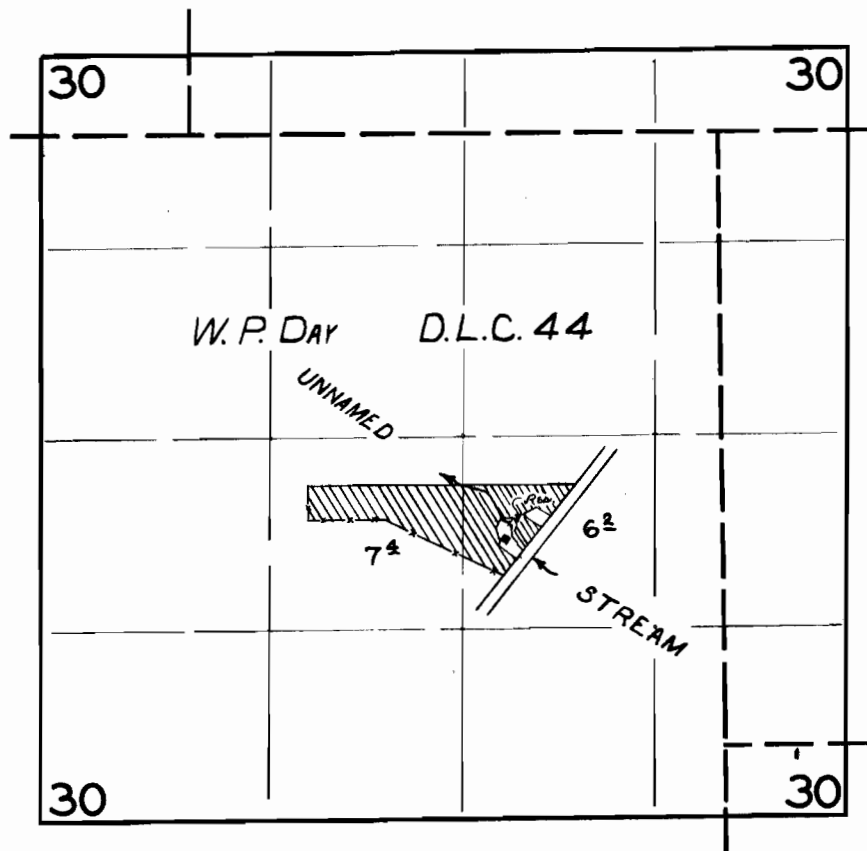

FINAL PROOF SURVEY
UNDER

R-32831 R-2216
Application No. 32753. Permit No. 25933.
IN NAME OF

A.F. & DOVIE BARNHART

Surveyed MAY 3, 1961, by C.O. BARTELS