


T.28 S. R. 6 W. W.M.

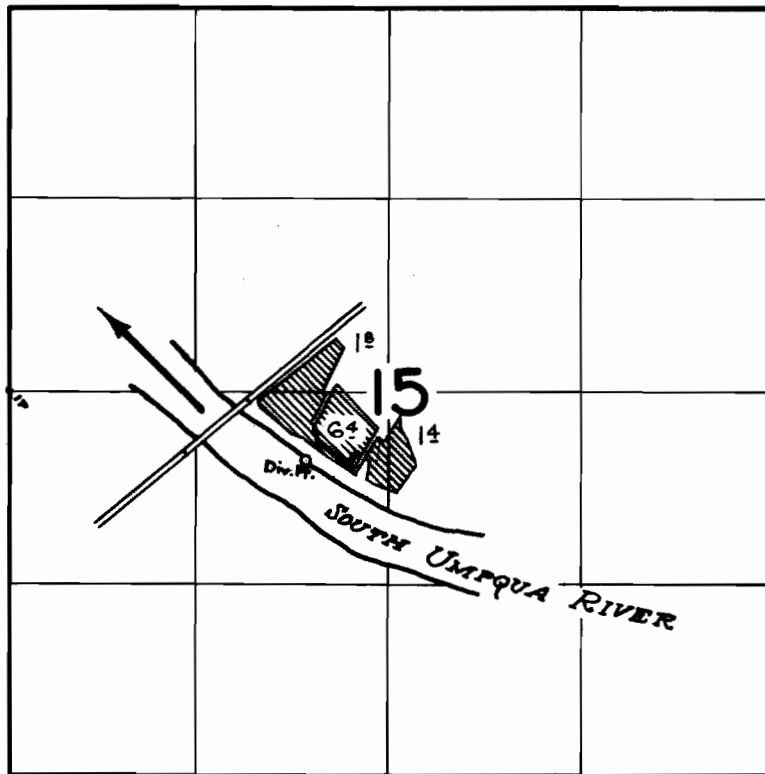

FINAL PROOF SURVEY
UNDER

Application No. 33058... Permit No. 26148....
IN NAME OF

M. DALE BENNETT

Surveyed July 18, 1961, by *L. Jackson*